


1 LOCATION OF WATER WELL: Fraction SW 1/4 NW 1/4 Section Number 21 Township Number T 33 S Range Number R 16 W EW
 County: Comanche

Distance and direction from nearest town or city street address of well if located within city?
12 south 8 east of Wilmore

2 WATER WELL OWNER: Vernie White
 RR#, St. Address, Box #: 600 S Boston Board of Agriculture, Division of Water Resources
 City, State, ZIP Code: Coldwater, Ks. 67029 Application Number:

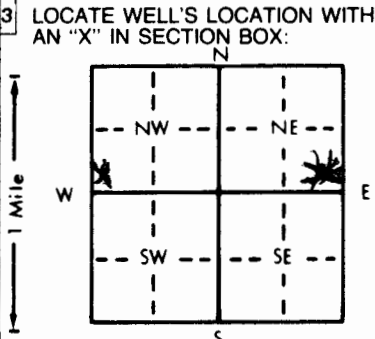

4 DEPTH OF COMPLETED WELL: 102 ft. ELEVATION:
 Depth(s) Groundwater Encountered 1. 85 ft. 2. ft. 3. ft.
 WELL'S STATIC WATER LEVEL 83 ft. below land surface measured on mo/day/yr 7-14-94
 Pump test data: Well water was ft. after hours pumping gpm
 Est. Yield 6 gpm: Well water was ft. after hours pumping gpm
 Bore Hole Diameter: 5 in. to 82 ft., and in. to ft.
 WELL WATER TO BE USED AS: 5 Public water supply 8 Air conditioning 11 Injection well
 1 Domestic 3 Feedlot 6 Oil field water supply 9 Dewatering 12 Other (Specify below)
2 Irrigation 4 Industrial 7 Lawn and garden only 10 Monitoring well
 Was a chemical/bacteriological sample submitted to Department? Yes No; If yes, mo/day/yr sample was submitted
 Water Well Disinfected? Yes No

5 TYPE OF BLANK CASING USED: 5 Wrought iron 8 Concrete tile CASING JOINTS: Glued Clamped
 1 Steel 3 RMP (SR) 6 Asbestos-Cement 9 Other (specify below) Welded
2 PVC 4 ABS 7 Fiberglass Threaded
 Blank casing diameter 5 in. to 82 ft., Dia. in. to ft., Dia. in. to ft.
 Casing height above land surface: 24 in., weight lbs./ft. Wall thickness or gauge No. 210
 TYPE OF SCREEN OR PERFORATION MATERIAL: 7 PVC 10 Asbestos-cement
 1 Steel 3 Stainless steel 5 Fiberglass 8 RMP (SR) 11 Other (specify)
 2 Brass 4 Galvanized steel 6 Concrete tile 9 ABS 12 None used (open hole)
 SCREEN OR PERFORATION OPENINGS ARE: 5 Gauzed wrapped 8 Saw cut 11 None (open hole)
 1 Continuous slot 3 Mill slot 6 Wire wrapped 9 Drilled holes
 2 Louvered shutter 4 Key punched 7 Torch cut 10 Other (specify)
 SCREEN-PERFORATED INTERVALS: From 82 ft. to 102 ft., From ft. to ft.
 From ft. to ft., From ft. to ft.
 GRAVEL PACK INTERVALS: From 20 ft. to 102 ft., From ft. to ft.
 From ft. to ft., From ft. to ft.

6 GROUT MATERIAL: 1 Neat cement 2 Cement grout 3 Bentonite 4 Other
 Grout intervals: From 0 ft. to 20 ft., From ft. to ft., From ft. to ft.
 What is the nearest source of possible contamination:
 1 Septic tank 4 Lateral lines 7 Pit privy 10 Livestock pens 14 Abandoned water well
 2 Sewer lines 5 Cess pool 8 Sewage lagoon 11 Fuel storage 15 Oil well/Gas well
 3 Watertight sewer lines 6 Seepage pit 9 Feedyard 12 Fertilizer storage 16 Other (specify below)
 13 Insecticide storage

Direction from well? none with in 500 ft How many feet?

FROM	TO	LITHOLOGIC LOG	FROM	TO	PLUGGING INTERVALS
0	3	soil			
3	9	clay			
9	79	Red shale			
79	85	lost circ., lation zone			
85	102	shale			

7 CONTRACTOR'S OR LANDOWNER'S CERTIFICATION: This water well was (1) constructed, (2) reconstructed, or (3) plugged under my jurisdiction and was completed on (mo/day/year) 7-14-94 and this record is true to the best of my knowledge and belief. Kansas Water Well Contractor's License No. 140. This Water Well Record was completed on (mo/day/yr) 7-30-94 under the business name of Lyman Inc. by (signature) Alan Lyman

OFFICE USE ONLY
T
R
EW
SEC.
1/4
1/4
1/4