

**WATER WELL RECORD Form WWC-5**

Division of Water Resources App. No.

Well ID


Original Record  Correction  Change in Well Use

**1 LOCATION OF WATER WELL:** Fracture  NE NW  SE SW  NW  SW

County: Comanche Section Number 22 Township Number T 33 S Range Number R 17 E  W

**2 WELL OWNER:** Last Name: Dunn First: Roger Street or Rural Address where well is located (if unknown, distance and direction from nearest town or intersection): If at owner's address, check here:

Business: Address: 925 Rd. 12  Hwy 160 & Rd 22 8 miles south on Rd. 22  
 City: Coldwater State: KS ZIP: 67029 To P Ave. 1/4 mile EAST 1/8 mile SW To well

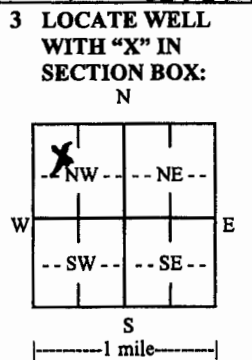

**4 DEPTH OF COMPLETED WELL:** 57 ft.

Depth(s) Groundwater Encountered: 1) 17 ft. 2) 17 ft. 3) 17 ft. or 4)  Dry Well

WELL'S STATIC WATER LEVEL: 17 ft.

below land surface, measured on (mo-day-yr) 10-16-17

above land surface, measured on (mo-day-yr) 10-16-17

Pump test data: Well water was 10-16-17 ft. after 1 hours pumping 10 gpm

Well water was 10-16-17 ft. after 1 hours pumping 10 gpm

Estimated Yield: 10 gpm

Bore Hole Diameter: 10 3/8 in. to 6 1/2 ft. and 6 1/2 in. to 6 1/2 ft.

**5 Latitude:** ..... (decimal degrees)

**Longitude:** ..... (decimal degrees)

**Horizontal Datum:**  WGS 84  NAD 83  NAD 27

**Source for Latitude/Longitude:**

GPS (unit make/model: .....)

(WAAS enabled?  Yes  No)

Land Survey  Topographic Map

Online Mapper: .....

**6 Elevation:** ..... ft.  Ground Level  TOC

**Source:**  Land Survey  GPS  Topographic Map  Other .....

**7 WELL WATER TO BE USED AS:**

1. Domestic:  Household  Lawn & Garden  Livestock

2.  Irrigation

3.  Feedlot

4.  Industrial

5.  Public Water Supply: well ID .....

6.  Dewatering: how many wells? .....

7.  Aquifer Recharge: well ID .....

8.  Monitoring: well ID .....

9. Environmental Remediation: well ID .....

Air Sparge  Soil Vapor Extraction  Recovery  Injection

10.  Oil Field Water Supply: lease .....

11. Test Hole: well ID .....

Cased  Uncased  Geotechnical

12. Geothermal: how many bores? .....

a) Closed Loop  Horizontal  Vertical

b) Open Loop  Surface Discharge  Inj. of Water

13.  Other (specify): .....

Was a chemical/bacteriological sample submitted to KDHE?  Yes  No If yes, date sample was submitted: .....

Water well disinfected?  Yes  No

**8 TYPE OF CASING USED:**  Steel  PVC  Other ..... CASING JOINTS:  Glued  Clamped  Welded  Threaded

Casing diameter 5 in. to 1 1/2 ft., Diameter 1 1/2 in. to 1 1/2 ft., Diameter 1 1/2 in. to 1 1/2 ft.

Casing height above land surface 24 in. Weight SDR 26 lbs./ft. Wall thickness or gauge No. ....

**TYPE OF SCREEN OR PERFORATION MATERIAL:**

Steel  Stainless Steel  Fiberglass  PVC  Other (Specify) .....

Brass  Galvanized Steel  Concrete tile  None used (open hole)

**SCREEN OR PERFORATION OPENINGS ARE:**

Continuous Slot  Mill Slot  Gauze Wrapped  Torch Cut  Drilled Holes  Other (Specify) .....

Louvered Shutter  Key Punched  Wire Wrapped  Saw Cut  None (Open Hole)

**SCREEN-PERFORATED INTERVALS:** From 17 ft. to 57 ft., From ..... ft. to ..... ft., From ..... ft. to ..... ft.

**GRAVEL PACK INTERVALS:** From 57 ft. to 17 ft., From ..... ft. to ..... ft., From ..... ft. to ..... ft.

**9 GROUT MATERIAL:**  Neat cement  Cement grout  Bentonite  Other .....

Grout Intervals: From 1 1/2 ft. to 0 ft., From ..... ft. to ..... ft., From ..... ft. to ..... ft.

**Nearest source of possible contamination:**

Septic Tank  Lateral Lines  Pit Privy  Livestock Pens  Insecticide Storage

Sewer Lines  Cess Pool  Sewage Lagoon  Fuel Storage  Abandoned Water Well

Watertight Sewer Lines  Seepage Pit  Feedyard  Fertilizer Storage  Oil Well/Gas Well

Other (Specify) 999 Distance from well? 999 ft.

10 FROM	TO	LITHOLOGIC LOG	FROM	TO	LITHO. LOG (cont.) or PLUGGING INTERVALS
0	5	Red Sandy Top Soil			
5	30	Red Sandy Clay			
30	45	Silty Grey Sand			
45	60	Red Clay			
60	65	White Clay			
Notes:					

**11 CONTRACTOR'S OR LANDOWNER'S CERTIFICATION:** This water well was  constructed,  reconstructed, or  plugged under my jurisdiction and was completed on (mo-day-year) 10-16-17 and this record is true to the best of my knowledge and belief. Kansas Water Well Contractor's License No. 692 This Water Well Record was completed on (mo-day-year) 10-16-17 under the business name of Crowd's Water Well Inc. Signature [Signature]

Mail 1 white copy along with a fee of \$5.00 for each constructed well to: Kansas Department of Health and Environment, Bureau of Water, GWTS Section, 1000 SW Jackson St., Suite 420, Topeka, Kansas 66612-1367. Mail one to Water Well Owner and retain one for your records. Telephone 785-296-5524.