


1 LOCATION OF WATER WELL: County: Comanche Fraction: NW 1/4 NW 1/4 SW 1/4 Section Number: 29 Township Number: T 33 S Range Number: R 19 E/W

Distance and direction from nearest town or city street address of well if located within city?
3 mi S SE of Protection Ks

2 WATER WELL OWNER: Dora Watson Est.
RR#, St. Address, Box #: Protection Ks 67127
City, State, ZIP Code: Protection Ks 67127
Board of Agriculture, Division of Water Resources
Application Number:

3 LOCATE WELL'S LOCATION WITH AN "X" IN SECTION BOX:

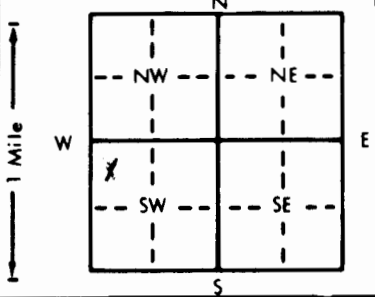

4 DEPTH OF COMPLETED WELL: 142 ft. ELEVATION:

Depth(s) Groundwater Encountered 1. ft. 2. ft. 3. ft.
WELL'S STATIC WATER LEVEL: 70 ft. below land surface measured on mo/day/yr
Pump test data: Well water was ft. after hours pumping gpm
Est. Yield gpm: Well water was ft. after hours pumping gpm
Bore Hole Diameter: in. to ft. and in. to ft.
WELL WATER TO BE USED AS:
5 Public water supply 8 Air conditioning 11 Injection well
6 Domestic 3 Feedlot 6 Oil field water supply 9 Dewatering 12 Other (Specify below)
2 Irrigation 4 Industrial 7 Lawn and garden only 10 Monitoring well livestock
Was a chemical/bacteriological sample submitted to Department? Yes.....No. X; If yes, mo/day/yr sample was submitted
Water Well Disinfected? Yes No

5 TYPE OF BLANK CASING USED:
1 Steel PVC 3 RMP (SR) 4 ABS 5 Wrought iron 6 Asbestos-Cement 7 Fiberglass 8 Concrete tile 9 Other (specify below) CASING JOINTS: Glued X Clamped
Blank casing diameter: 5 in. to 130 ft., Dia. in. to ft., Dia. in. to ft.
Casing height above land surface: 24 in., weight 2.87 lbs./ft. Wall thickness or gauge No. SQR21

TYPE OF SCREEN OR PERFORATION MATERIAL:
1 Steel 2 Brass 3 Stainless steel 4 Galvanized steel 5 Fiberglass 6 Concrete tile 8 RMP (SR) 9 ABS 10 Asbestos-cement 11 Other (specify) 12 None used (open hole)
SCREEN OR PERFORATION OPENINGS ARE:
1 Continuous slot 2 Louvered shutter 3 Mill slot 4 Key punched 5 Gauzed wrapped 6 Wire wrapped 7 Torch cut 8 Saw cut 11 None (open hole) 9 Drilled holes 10 Other (specify)

SCREEN-PERFORATED INTERVALS: From 130 ft. to 142 ft., From ft. to ft.
GRAVEL PACK INTERVALS: From 142 ft. to 125 ft., From ft. to ft.

6 GROUT MATERIAL: 1 Neat cement 2 Cement grout 3 Bentonite 4 Other
Grout Intervals: From 125 ft. to 100 ft., From 20 ft. to 0 ft., From ft. to ft.
What is the nearest source of possible contamination:
1 Septic tank 2 Sewer lines 3 Watertight sewer lines 4 Lateral lines 5 Cess pool 6 Seepage pit 7 Pit privy 8 Sewage lagoon 9 Feedyard 10 Livestock pens 11 Fuel storage 12 Fertilizer storage 13 Insecticide storage 14 Abandoned water well 15 Oil well/Gas well 16 Other (specify below)

Direction from well? North How many feet? 500

FROM	TO	LITHOLOGIC LOG	FROM	TO	PLUGGING INTERVALS
0	3	<u>Topsail</u>			
3	42	<u>Intermittent layers of red + grey clay</u>			
42	65	<u>red clay very hard</u>			
65	110	<u>red sandstone medium hard</u>			
110	130	<u>red sandstone - very hard</u>			
130	142	<u>red siltstone - soft</u>			

7 CONTRACTOR'S OR LANDOWNER'S CERTIFICATION: This water well was (1) constructed, (2) reconstructed, or (3) plugged under my jurisdiction and was completed on (mo/day/year) 10-26-95 and this record is true to the best of my knowledge and belief. Kansas Water Well Contractor's License No. 577 This Water Well Record was completed on (mo/day/yr) 10-27-95 under the business name of Ashland Well Service by (signature) [Signature]

OFFICE USE ONLY
T
R
E/W
SEC.
1/4
1/4
1/4