


BH-251 mw-15

1 LOCATION OF WATER WELL: County: Comanche Fraction: NW 1/4 SE 1/4 NW 1/4 Section Number: 3 Township Number: T 33 S Range Number: R 20 EW

Distance and direction from nearest town or city street address of well if located within city? NW corner of united Methodist Church, Protection KS

2 WATER WELL OWNER: Orlin Loucks
 RR#, St. Address, Box #: Box 568
 City, State, ZIP Code: Protection KS 67127
 Board of Agriculture, Division of Water Resources
 Application Number:

3 LOCATE WELL'S LOCATION WITH AN "X" IN SECTION BOX:

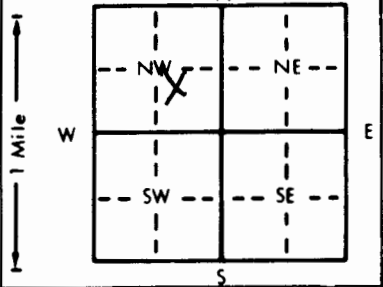

4 DEPTH OF COMPLETED WELL: 25.0 ft. ELEVATION: NA
 Depth(s) Groundwater Encountered 1. NA ft. 2. ft. 3. ft.
 WELL'S STATIC WATER LEVEL: 19.80 ft. below land surface measured on mo/day/yr 7-8-92
 Pump test data: Well water was ft. after hours pumping gpm
 Est. Yield gpm: Well water was ft. after hours pumping gpm
 Bore Hole Diameter: 8 in. to ft. and in. to ft.
 WELL WATER TO BE USED AS:
 5 Public water supply 8 Air conditioning 11 Injection well
 1 Domestic 3 Feedlot 6 Oil field water supply 9 Dewatering 12 Other (Specify below)
 2 Irrigation 4 Industrial 7 Lawn and garden only 10 Monitoring well
 Was a chemical/bacteriological sample submitted to Department? Yes No X; If yes, mo/day/yr sample was submitted
 Water Well Disinfected? Yes No X

5 TYPE OF BLANK CASING USED:
 1 Steel PVC 3 RMP (SR) 4 ABS 5 Wrought iron 6 Asbestos-Cement 7 Fiberglass 8 Concrete tile 9 Other (specify below) 10 Asbestos-cement
 Blank casing diameter: 2 in. to ft. Dia. in. to ft. Dia. in. to ft. Dia. in. to ft.
 Casing height above land surface: Flush in., weight: 703 lbs./ft. Wall thickness or gauge No. 154
 TYPE OF SCREEN OR PERFORATION MATERIAL:
 1 Steel 2 Brass 3 Stainless steel 4 Galvanized steel 5 Fiberglass 6 Concrete tile 7 RMP (SR) 8 ABS 9 Other (specify) 10 Asbestos-cement 11 Other (specify) 12 None used (open hole)

SCREEN OR PERFORATION OPENINGS ARE:
 1 Continuous slot 2 Louvered shutter 3 Mill slot 4 Key punched 5 Gauzed wrapped 6 Wire wrapped 7 Torch cut 8 Saw cut 9 Drilled holes 10 Other (specify) 11 None (open hole)
 SCREEN-PERFORATED INTERVALS: From 10.0 ft. to 24.55 ft. From ft. to ft. From ft. to ft. From ft. to ft.
 GRAVEL PACK INTERVALS: From 9.0 ft. to 24.55 ft. From ft. to ft. From ft. to ft. From ft. to ft.

6 GROUT MATERIAL: 1 Neat cement 2 Cement grout 3 Bentonite 4 Other
 Grout Intervals: From 9.0 ft. to 1.0 ft. From ft. to ft. From ft. to ft. From ft. to ft.
 What is the nearest source of possible contamination:
 1 Septic tank 2 Sewer lines 3 Watertight sewer lines 4 Lateral lines 5 Cess pool 6 Seepage pit 7 Pit privy 8 Sewage lagoon 9 Feedyard 10 Livestock pens 11 Fuel storage 12 Fertilizer storage 13 Insecticide storage 14 Abandoned water well 15 Oil well/Gas well 16 Other (specify below)

Direction from well? Southeast How many feet? 240

FROM	TO	LITHOLOGIC LOG	FROM	TO	PLUGGING INTERVALS
0.0	4.0	Silt, Clayey			
4.0	10.0	Sand, very fine grained silty, clayey			
10.0	16.0	Sand, very fine grained, slightly silty			
16.0	19.5	Clay			
19.5	24.0	Clay, sandy (very fine grained)			
24.0	25.0	Clay			
Monitor Well Waiver granted on 6-11-92 for KDHE Trust Fund Loucks Service by Don Taylor					

7 CONTRACTOR'S OR LANDOWNER'S CERTIFICATION: This water well was (1) constructed, (2) reconstructed, or (3) plugged under my jurisdiction and was completed on (mo/day/year) 7-6-92 and this record is true to the best of my knowledge and belief. Kansas Water Well Contractor's License No. 531 This Water Well Record was completed on (mo/day/yr) 7-29-92 under the business name of Geotechnical Services, Inc by (signature) Allison Irwin

OFFICE USE ONLY
T
R
EW
SEC.
1/4
1/4
1/4