


BH-9/mw-5

| | | | | |
|--|---|----------------------------|----------------------------------|--|
| 1 LOCATION OF WATER WELL: County: <u>Comanche</u> | Fraction <u>NW 1/4 SE 1/4 NW 1/4</u> | Section Number <u>3</u> | Township Number <u>T 33 S</u> | Range Number <u>R 20 E</u> (W) |
|--|---|----------------------------|----------------------------------|--|

Distance and direction from nearest town or city street address of well if located within city?
SW Corner of Broadway & Pine, Protection KS

| | | |
|---|---|--|
| 2 WATER WELL OWNER: RR#, St. Address, Box # : City, State, ZIP Code | <u>Mona Allender</u> <u>111 N Broadway</u> <u>Protection KS 67127</u> | Board of Agriculture, Division of Water Resources Application Number: |
|---|---|--|

| |
|--|
| 3 LOCATE WELL'S LOCATION WITH AN "X" IN SECTION BOX: |
|--|

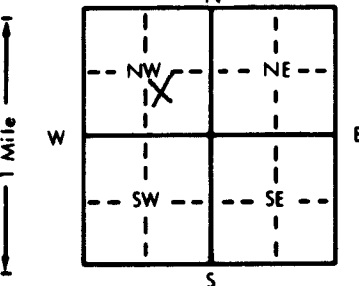

| |
|---|
| 4 DEPTH OF COMPLETED WELL: <u>25.0</u> ft. ELEVATION: <u>NA</u> |
| Depth(s) Groundwater Encountered 1. <u>NA</u> ft. 2. _____ ft. 3. _____ ft. |
| WELL'S STATIC WATER LEVEL <u>19.42</u> ft. below land surface measured on mo/day/yr <u>7-2-92</u> |
| Pump test data: Well water was _____ ft. after _____ hours pumping _____ gpm |
| Est. Yield _____ gpm: Well water was _____ ft. after _____ hours pumping _____ gpm |
| Bore Hole Diameter: <u>8</u> in. to _____ ft., and _____ in. to _____ ft. |
| WELL WATER TO BE USED AS: |
| 5 Public water supply 8 Air conditioning 11 Injection well |
| 1 Domestic 3 Feedlot 6 Oil field water supply 9 Dewatering 12 Other (Specify below) |
| 2 Irrigation 4 Industrial 7 Lawn and garden only <u>10 Monitoring well</u> |
| Was a chemical/bacteriological sample submitted to Department? Yes _____ No <u>X</u> ; If yes, mo/day/yr sample was submitted _____ |
| Water Well Disinfected? Yes _____ No <u>X</u> |

| | | | |
|--|----------------|-------------------|--|
| 5 TYPE OF BLANK CASING USED: | 5 Wrought iron | 8 Concrete tile | CASING JOINTS: Glued _____ Clamped _____ |
| 1 Steel | 3 RMP (SR) | 6 Asbestos-Cement | 9 Other (specify below) |
| <u>2 PVC</u> | 4 ABS | 7 Fiberglass | Welded _____ |
| Blank casing diameter _____ in. to _____ ft., Dia _____ in. to _____ ft., Dia _____ in. to _____ ft. | | | Threaded: <u>Flush</u> |
| Casing height above land surface: <u>Flush</u> in., weight <u>7.03</u> lbs./ft. Wall thickness or gauge No. <u>154</u> | | | |

| | | |
|---|--------------------|--------------------------|
| TYPE OF SCREEN OR PERFORATION MATERIAL: | 7 PVC | 10 Asbestos-cement |
| 1 Steel | 3 Stainless steel | 5 Fiberglass |
| 2 Brass | 4 Galvanized steel | 6 Concrete tile |
| 3 RMP (SR) | 9 ABS | 11 Other (specify) _____ |
| 12 None used (open hole) | | |

| | | | |
|-------------------------------------|------------------|--------------------------|---------------------|
| SCREEN OR PERFORATION OPENINGS ARE: | 5 Gauzed wrapped | 8 Saw cut | 11 None (open hole) |
| 1 Continuous slot | 6 Wire wrapped | 9 Drilled holes | |
| 2 Louvered shutter | 7 Torch cut | 10 Other (specify) _____ | |
| 3 Mill slot | | | |

| | | | |
|------------------------------|--|-----------------------------|-----------------------------|
| SCREEN-PERFORATED INTERVALS: | From <u>10.0</u> ft. to <u>24.55</u> ft. | From _____ ft. to _____ ft. | From _____ ft. to _____ ft. |
| GRAVEL PACK INTERVALS: | From <u>9.0</u> ft. to <u>24.55</u> ft. | From _____ ft. to _____ ft. | From _____ ft. to _____ ft. |

| | | | | |
|--|-----------------------------|-----------------------------|-----------------------------|-----------------------------|
| 6 GROUT MATERIAL: | 1 Neat cement | 2 Cement grout | <u>3 Bentonite</u> | 4 Other _____ |
| Grout Intervals: From <u>9.0</u> ft. to <u>1.0</u> ft. | From _____ ft. to _____ ft. | From _____ ft. to _____ ft. | From _____ ft. to _____ ft. | From _____ ft. to _____ ft. |

| | | |
|---|-------------------|--------------------------|
| What is the nearest source of possible contamination: | 10 Livestock pens | 14 Abandoned water well |
| 1 Septic tank | 4 Lateral lines | 7 Pit privy |
| 2 Sewer lines | 5 Cess pool | 8 Sewage lagoon |
| 3 Watertight sewer lines | 6 Seepage pit | 9 Feedyard |
| | | <u>11 Fuel storage</u> |
| | | 12 Fertilizer storage |
| | | 13 Insecticide storage |
| | | 16 Other (specify below) |

Direction from well? Northeast How many feet? 40

| FROM | TO | LITHOLOGIC LOG | FROM | TO | PLUGGING INTERVALS |
|--|------|---|------|----|--------------------|
| 0.0 | 0.5 | Concrete | | | |
| 0.5 | 9.0 | Clay, plastic | | | |
| 9.0 | 15.0 | Silt, clayey, slightly plastic | | | |
| 15.0 | 20.5 | Clay, plastic, w/ some indeterminate very fine silty sand streaks | | | |
| 20.5 | 25.0 | Clay, plastic | | | |
| <p>Monitor Well waiver granted on 6-11-92 for KHE Trust Fund for Loucks Service by Don Taylor.</p> | | | | | |

| |
|--|
| 7 CONTRACTOR'S OR LANDOWNER'S CERTIFICATION: This water well was <u>(1) constructed</u> , (2) reconstructed, or (3) plugged under my jurisdiction and was completed on (mo/day/year) <u>7-1-92</u> and this record is true to the best of my knowledge and belief. Kansas Water Well Contractor's License No. <u>531</u> . This Water Well Record was completed on (mo/day/yr) <u>7-27-92</u> under the business name of <u>Geotechnical Services, Inc</u> by (signature) <u>Allison Irwin</u> |
|--|

OFFICE USE ONLY
T
R
EW
SEC.