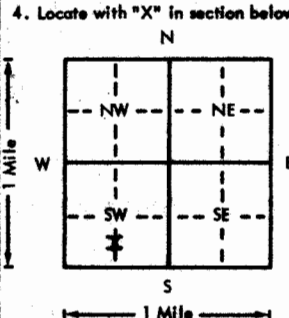


USE TYPEWRITER OR BALL POINT PEN-PRESS FIRMLY, PRINT CLEARLY.

WATER WELL RECORD  
KSA 82a-1201-1215

Kansas Department of Health and Environment-Division of Environment  
(Water well Contractors)  
Topeka, Kansas 66620

1. Location of well:	County <b>Comanche</b>	Fraction <b>03 1/4 SW 1/4 1/4</b>	Section number <b>26</b>	Township number <b>T 33s</b>	Range number <b>S R 20W E/W</b>
2. Distance and direction from nearest town or city: Street address of well location if in city: <b>1 1/2 mi e, 4s 3/4w from Protection, Ks.</b>			3. Owner of well: R.R. or street: <b>Aaron Willems, Protection, Ks.</b> City, state, zip code: <b>67127</b>		
4. Locate with "X" in section below: Sketch map: 			6. Bore hole dia. <b>8.75</b> in. Completion date _____ Well depth <b>27</b> ft. <b>7-7-79</b>		
5. Type and color of material			7. <input checked="" type="checkbox"/> Cable tool <input type="checkbox"/> Rotary <input type="checkbox"/> Driven <input type="checkbox"/> Dug <input type="checkbox"/> Hollow rod <input type="checkbox"/> Jetted <input type="checkbox"/> Bored <input type="checkbox"/> Reverse rotary		
			8. Use: <input type="checkbox"/> Domestic <input type="checkbox"/> Public supply <input type="checkbox"/> Industry <input type="checkbox"/> Irrigation <input type="checkbox"/> Air conditioning <input checked="" type="checkbox"/> Stock <input type="checkbox"/> Lawn <input type="checkbox"/> Oil field water <input type="checkbox"/> Other		
From To			9. Casing: Material <b>EMP</b> Height: Above or below Threaded <input type="checkbox"/> Welded <input type="checkbox"/> Surface <b>24</b> in. RMP <input type="checkbox"/> PVC <input type="checkbox"/> Weight _____ lbs./ft. Dia. <b>5</b> in. to _____ ft. depth Wall thickness _____ in. or Dia. _____ in. to _____ ft. depth Gauge No. _____		
			10. Screen: Manufacturer's name <b>Foss &amp; Lowell</b> Type <b>EMP</b> Dia. <b>5</b> in. Slot/gauze <b>20</b> Length <b>5</b> Set between <b>20</b> ft. and <b>27</b> ft. _____ ft. and _____ ft. Gravel pack? <b>Yes</b> Size range of material: <b>1/16-3/4</b>		
Blow sand red tint from red hill nearby			0	20	11. Static water level: _____ no./day/yr. <b>18</b> ft. below land surface Date <b>7-7-79</b>
Sand, mixed fine and coarse			20	25	12. Pumping level below land surfaces: _____ ft. after _____ hrs. pumping _____ g.p.m. _____ ft. after _____ hrs. pumping _____ g.p.m. Estimated maximum yield _____ g.p.m.
Red clay very sticky			25	27	13. Water sample submitted: _____ no./day/yr. <input type="checkbox"/> Yes <input checked="" type="checkbox"/> No Date _____
					14. Well head completion: <input type="checkbox"/> Pitless adapter _____ inches above grade
					15. Well grouted? <b>Yes</b> With: <input type="checkbox"/> Neat cement <input checked="" type="checkbox"/> Bentonite <input type="checkbox"/> Concrete Depth from <b>10</b> ft. to <b>top</b> ft.
					16. Nearest source of possible contamination: ft. _____ Direction _____ Type _____ Well disinfected upon completion? <input checked="" type="checkbox"/> Yes <input type="checkbox"/> No
					17. Pump: <input checked="" type="checkbox"/> Not installed Manufacturer's name <b>Ormotor</b> Model number _____ HP <b>1/2</b> Volts _____ Length of drop pipe _____ ft. capacity _____ g.p.m. Type: <input type="checkbox"/> Submersible <input checked="" type="checkbox"/> Turbine <input type="checkbox"/> Jet <input type="checkbox"/> Reciprocating <input type="checkbox"/> Centrifugal <input type="checkbox"/> Other
18. Elevation _____ Remarks: <b>Piece of 6 5/8 iron pipe set in concrete to level of tank</b>			20. Water well contractor's certification: This well was drilled under my jurisdiction and this report is true to the best of my knowledge and belief. <b>Walter Blackwith Shop 228</b> Business _____ Protection, Ks. 67127 Address _____ Signed <b>Walter Blackwith</b> Date <b>7-11-79</b> Authorized representative		

33 200 26  
Sec  
1/4 1/4 2/4

Forward the white, blue and pink copies to the Department of Health and Environment

Form WWC-5