USE TYPEWRITER OR BALL POINT PEN-PRESS FIRMLY, PRINT CLEARLY.

✓
WATER WELL RECORD
KSA 82a-1201-1215

T R EW sec 1/4 1/4 1/4 No.

Kansas State Dept. Of Health
(Water Well Contractors)
Forbes-Bldg. 740
Topeka, Kansas 66620

1 Location of well:	County	Township name	Fraction	Section number	Town number	Range number
	COMANCHE	PROTECTION	NE¼ SE¼ NE¼	26	33S	20W

Distance and direction from nearest town or city: 3S, 1E OF PROTECTION, KS.

Street address of well location if in city:

3 Owner of well: JAY CHRISTOPHER

Address: PROTECTION KS 67127

Locate with "X" in section below:

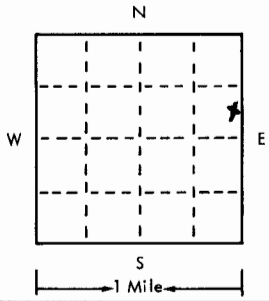

Sketch map:

2 Type and color of material	From	To
FINE SAND	0	18
WATER SAND (COARSE)	18	26
BLUE, BLACK CLAY	26	28

(use a second sheet if needed)

4 Well depth: 28 ft. Date of completion 11-10-75
Well diameter 8 in.

5 ☒ Cable tool ☐ Rotary ☐ Driven ☐ Dug ☐ Hollow rod ☐ Jetted ☐ Bored ☐ Reverse rotary

6 Use: ☐ Domestic ☐ Public supply ☐ Industry ☐ Irrigation ☐ Air conditioning ☐ Commercial ☐ Test well ☒ STOCK WATER

7 Casing: Material RMP Height: above/below
Threaded ☐ Welded ☐ Surface 15 in.
Diam. 5 in. to 28 ft. depth Weight ___ lbs./ft.
___ in. to ___ ft. depth Drive shoe? ☐ Yes ☒ No

8 Screen:
Manufacturer JESS + LOWEL
Type RMP Dia. 5
Slot/gauze 40W Length 10FT
Set between 18 ft. and 28 ft.
Fittings:
Gravel pack ☒ Yes ☐ No Size range of material ¼-¾

9 Static water level:
10 ft. below land surface Date 11-10-75

10 Pumping level below land surfaces:
___ ft. after ___ hrs. pumping ___ g.p.m.
___ ft. after ___ hrs. pumping ___ g.p.m.
Estimated maximum yield ___ g.p.m.

11 Water sample submitted:
☐ Yes ☒ No Date ___

12 Well head completion:
☐ Pitless adapter 24 Inches above grade

13 Well grouted? ☒ Yes ☐ No
☐ Neat cement ☐ Bentonite ☐ CONCRETE
Depth: From 0 ft. to 10 ft.

14 Nearest source of possible contamination: NONE
ft. ___ Direction ___ Type ___
Well disinfected upon completion? ☒ Yes ☐ No

15 Pump: ☒ Not installed
Manufacturer's name ___
Model number ___ HP ___ Volts ___
Length of drop pipe ___ ft. capacity ___ g.m.p.
Type:
☐ Submersible ☐ Turbine
☐ Jet ☐ Reciprocating
☐ Certrifugal ☐ Other

16 Remarks: elevation well is on a slight rigde in pasture near a creek

Topography:
☐ Hill
☐ Slope
☐ Upland
☐ Valley

17 Water well contractor's certification:
This well was drilled under my jurisdiction and this report is true to the best of my knowledge and belief.
Business name WYMER BLACKSMITH SHOP License No. 228
Address PROTECTION, KS.
Signed Kenneth Larimer Date 11-18-75
Authorized representative

33 20 W 26 NE SE NE

Forward the white, blue and pink copies to the Kansas State Dept. Of Health.

Form WWC-5

677-H