


WATER WELL RECORD Form WWC-5 KSA 82a-1212

1 LOCATION OF WATER WELL: County: Clark Fraction NW 1/4 NW 1/4 NW 1/4 Section Number 2 Township Number T 33 S Range Number R 21 E/W

Distance and direction from nearest town or city street address of well if located within city? 5 mi W of Protection, KS, 1 mi N of US Hwy 160

2 WATER WELL OWNER: DCP Midstream, LP RR#, St. Address, Box #: 370 17th Street, Ste 2500 City, State, ZIP Code: Denver, CO 80202 Board of Agriculture, Division of Water Resources Application Number:

3 LOCATE WELL'S LOCATION WITH AN "X" IN SECTION BOX:

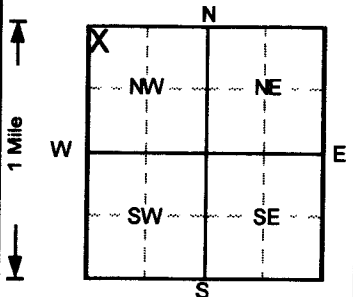

4 DEPTH OF COMPLETED WELL: 37 ft ELEVATION: Depth(s) Groundwater Encountered 1. 25 ft 2. ft 3. ft WELL'S STATIC WATER LEVEL: ft below land surface measured on mo/day/yr Pump test data: Well water was NA ft after hours pumping gpm Est. Yield NA gpm: Well water was ft after hours pumping gpm Bore Hole Diameter 8 in. to 37 ft, and in. to ft WELL WATER TO BE USED AS: 5 Public water supply 8 Air conditioning 11 Injection well 1 Domestic 3 Feedlot 6 Oil field water supply 9 Dewatering 12 Other (Specify below) Air sparge 2 Irrigation 4 Industrial 7 Lawn and garden only 10 Monitoring Well Was a chemical/bacteriological sample submitted to Department? Yes No (checked) If yes, mo/day/yr sample was submitted Water Well Disinfection? Yes No (checked)

5 TYPE OF BLANK CASING USED: 1 Steel 3 RMP (SR) 5 Wrought iron 8 Concrete tile CASING JOINTS: Glued Clamped 2 PVC (checked) 4 ABS 6 Asbestos-Cement 9 Other (specify below) Welded Threaded (checked) Blank casing diameter 2 in. to 32 ft, Dia in. to ft, Dia in. to ft Casing height above land surface 24 in., weight lbs./ft. Wall thickness or gauge No. Sch. 40

TYPE OF SCREEN OR PERFORATION MATERIAL 1 Steel 3 Stainless steel 5 Fiberglass 7 PVC (checked) 10 Asbestos-cement 2 Brass 4 Galvanized steel 6 Concrete tile 8 RMP (SR) 11 Other (specify) 12 None used (open hole)

SCREEN OR PERFORATION OPENINGS ARE: 1 Continuous slot 3 Mill slot (checked) 5 Gauzed wrapped 8 Saw cut 11 None (open hole) 2 Louvered shutter 4 Key punched 6 Wire wrapped 9 Drilled holes 7 Torch cut 10 Other (specify)

SCREEN-PERFORATED INTERVALS: From 32 ft to 37 ft, From ft to ft, From ft to ft GRAVEL PACK INTERVALS: From 30 ft to 37 ft, From ft to ft, From ft to ft

6 GROUT MATERIAL: 1 Neat cement 2 Cement grout 3 Bentonite (checked) 4 Other Concrete (checked) Grout Intervals: From 0 ft to 2.5 ft, From 2.5 ft to 30 ft, From ft to ft What is the nearest source of possible contamination: 1 Septic tank 4 Lateral lines 7 Pit privy 10 Livestock pens 14 Abandoned water well 2 Sewer lines 5 Cess pool 8 Sewage lagoon 11 Fuel storage 15 Oil well/Gas well 3 Watertight sewer lines 6 Seepage pit 9 Feedyard 12 Fertilizer storage 16 Other (specify below) 13 Insecticide storage Direction from well? How many feet?

Table with columns: FROM, TO, LITHOLOGIC LOG, FROM, TO, PLUGGING INTERVALS. Rows include lithologic logs: Sand, clayey, silty, Red Brown (0-5, 5-8, 8-16, 20-23, 23-33.5, 33.5-37) and AS-7.

7 CONTRACTOR'S OR LANDOWNER'S CERTIFICATION: This water well was (1) constructed, (2) reconstructed, or (3) plugged under my jurisdiction and was completed on (mo/day/year) 12/3/2015 and this record is true to the best of my knowledge and belief. Kansas Water Well Contractor's License No. 527 This Water Well Record was completed on (mo/day/yr) 12/31/15 under the business name of GeoCore, Inc. by (signature) Dan Bell