

USE TYPEWRITER OR BALL POINT PEN-PRESS FIRMLY, PRINT CLEARLY.

SITKA SW

3321 W 31 CSW
T R EW sec 1/4 1/4 1/4 No.


WATER WELL RECORD
KSA 82a-1201-1215

Kansas State Dept. Of Health
(Water Well Contractors)
Forbes-Bldg. 740
Topeka, Kansas 66620

(center)

1 Location of well: County Clark Township name X Fraction SW 1/4 Section number 31 Town number T335 Range number R21W

Distance and direction from nearest town or city: SITKA 5000 Highway 183 4 Miles. 3/4 West 1/2 No.
Street address of well location if in city: 3/4 West 1/2 No.
3 Owner of well: BOZIDEN BROTHERS
Address: Box 663 Ashland Ks.

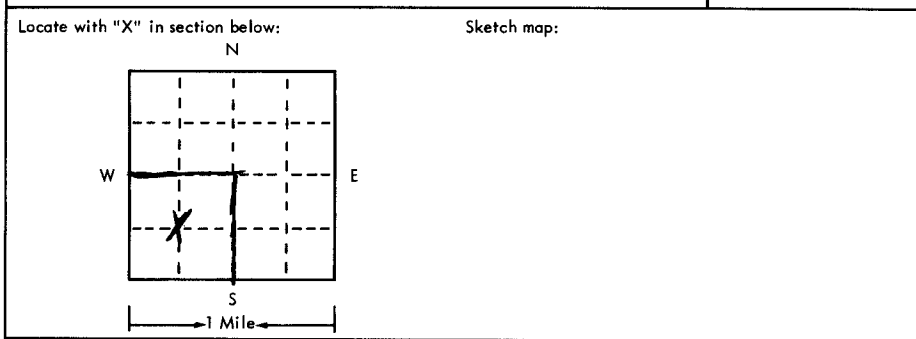

4 Well depth: 105 ft. Date of completion 12/9/75
Well diameter 9" in. 5" casing
5 Cable tool Rotary Driven Dug
 Hollow rod Jetted Bored Reverse rotary
6 Use: Domestic Public supply Industry
 Irrigation Air conditioning Commercial
 Test well STEEL
7 Casing: Material PVC Height: above/ below
Threaded Welded Surface 18 in.
Diam. 2 1/2 in. Weight 200 lbs./ft.
5" in. to 105 ft. depth Drive shoe? Yes No
in. to in. ft. depth!

2	Type and color of material	From	To
	<u>Surface</u>	<u>0</u>	<u>2</u>
	<u>Red Bed</u>	<u>2</u>	<u>60</u>
	<u>Fine sand + Paris Rock mixed</u>	<u>60</u>	<u>100</u>
	<u>Dark Red Bed + Green Clay</u>	<u>100</u>	<u>105</u>
	<u>BROCK 2'</u>		
	<u>Pro. of well</u>		

8 Screen: Sawed
Manufacturer Crown
Type PVC Dia. 5"
Slot/gauze 1/4" Length 20'
Set between 35 ft. and 105 ft.
Fittings: Balled Collars
Gravel pack Yes No Size range of material 1/8"
9 Static water level:
75 ft. below land surface Date 12/9/75
10 Pumping level below land surfaces:
55 ft. after 1 hrs. pumping 20 g.p.m.
ft. after hrs. pumping g.p.m.
Estimated maximum yield 20 g.p.m.
11 Water sample submitted:
 Yes No Date _____
12 Well head completion:
 Pitless adapter 18" inches above grade
13 Well grouted? Yes No
 Neat cement Bentonite
Depth: From 0 ft. to 12 ft.
14 Nearest source of possible contamination:
ft. None Direction None Type _____
Well disinfected upon completion? Yes No
15 Pump: Not installed
Manufacturer's name _____
Model number _____ HP _____ Volts _____
Length of drop pipe _____ ft. capacity _____ g.p.m.
Type:
 Submersible Turbine
 Jet Reciprocating
 Centrifugal Other

16 Remarks: elevation
Topography:
 Hill
 Slope
 Upland
 Valley
1848
1446
1848

17 Water well contractor's certification:
This well was drilled under my jurisdiction and this report is true to the best of my knowledge and belief.
Craig Water Well 239
Business name _____ License No. _____
Address Box 521 Woodward Okla.
Signed [Signature] Date 12/9/75
Authorized representative

33 21 W 31 CSW