


1 LOCATION OF WATER WELL: County: Clark Fraction: SE 1/4 NW 1/4 SE 1/4 Section Number: 24 Township Number: T 33 S Range Number: R 22 E

Distance and direction from nearest town or city street address of well if located within city?
1 1/2 mi south of Ashland Ks

2 WATER WELL OWNER: Hensley Farms
 RR#, St. Address, Box #: RR Ashland, Ks 67831
 City, State, ZIP Code: Ashland, Ks 67831
 Board of Agriculture, Division of Water Resources
 Application Number:

3 LOCATE WELL'S LOCATION WITH AN "X" IN SECTION BOX:
 4 DEPTH OF COMPLETED WELL: 70 ft. ELEVATION: 1920

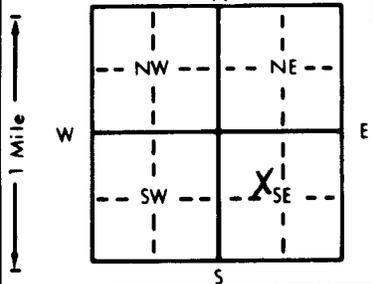

Depth(s) Groundwater Encountered 1. 23 ft. 2. _____ ft. 3. _____ ft.
 WELL'S STATIC WATER LEVEL 23 ft. below land surface measured on mo/day/yr 5-13-96
 Pump test data: Well water was 35 ft. after 2 hours pumping 15 gpm
 Est. Yield 15+ gpm: Well water was _____ ft. after _____ hours pumping _____ gpm
 Bore Hole Diameter: 9" in. to 70' ft., and _____ in. to _____ ft.
 WELL WATER TO BE USED AS:
 5 Public water supply 8 Air conditioning 11 Injection well
 1 Domestic 3 Feedlot 6 Oil field water supply 9 Dewatering 12 Other (Specify below)
 2 Irrigation 4 Industrial 7 Lawn and garden only 10 Monitoring well livestock windmill
 Was a chemical/bacteriological sample submitted to Department? Yes NO If yes, mo/day/yr sample was submitted _____
 Water Well Disinfected? Yes No

5 TYPE OF BLANK CASING USED:
 1 Steel 3 RMP (SR) 5 Wrought iron 8 Concrete tile CASING JOINTS: Glued Clamped _____
 2 PVC 4 ABS 6 Asbestos-Cement 9 Other (specify below) Welded _____
 7 Fiberglass Threaded _____

Blank casing diameter: 5" in. to _____ ft., Dia _____ in. to _____ ft., Dia _____ in. to _____ ft.
 Casing height above land surface: 24 in., weight 2.87 lbs./ft. Wall thickness or gauge No. 265 SDR21

TYPE OF SCREEN OR PERFORATION MATERIAL:
 1 Steel 3 Stainless steel 5 Fiberglass 8 RMP (SR) 10 Asbestos-cement
 2 Brass 4 Galvanized steel 6 Concrete tile 9 ABS 11 Other (specify) _____
 12 None used (open hole)

SCREEN OR PERFORATION OPENINGS ARE:
 1 Continuous slot 3 Mill slot 5 Gauzed wrapped 8 Saw cut 11 None (open hole)
 2 Louvered shutter 4 Key punched 6 Wire wrapped 9 Drilled holes
 7 Torch cut 10 Other (specify) _____

SCREEN-PERFORATED INTERVALS: From 30 ft. to 70 ft., From _____ ft. to _____ ft.
 From _____ ft. to _____ ft., From _____ ft. to _____ ft.
 GRAVEL PACK INTERVALS: From 25 ft. to 70 ft., From _____ ft. to _____ ft.
 From _____ ft. to _____ ft., From _____ ft. to _____ ft.

6 GROUT MATERIAL: 1 Neat cement 2 Cement grout 3 Bentonite 4 Other _____
 Grout Intervals: From 25 ft. to 0 ft., From _____ ft. to _____ ft., From _____ ft. to _____ ft.

What is the nearest source of possible contamination:
 1 Septic tank 4 Lateral lines 7 Pit privy 10 Livestock pens 14 Abandoned water well
 2 Sewer lines 5 Cess pool 8 Sewage lagoon 11 Fuel storage 15 Oil well/Gas well
 3 Watertight sewer lines 6 Seepage pit 9 Feedyard 12 Fertilizer storage 16 Other (specify below) _____
 13 Insecticide storage _____
 Direction from well? West How many feet? 400

FROM	TO	LITHOLOGIC LOG	FROM	TO	PLUGGING INTERVALS
0	3	Topsoil			
3	10	Sandy clay - Brown			
10	17	Clay - Red			
17	23	Clay - Red & Blue			
23	29	Sand - Fine			
29	44	Sand - medium			
44	48	Sand - Coarse			
48	61	Sand - Fine with some Red siltstone (liver mud)			
61	68	Sand - Fine			
68	70	Clay - Red - Hard			

7 CONTRACTOR'S OR LANDOWNER'S CERTIFICATION: This water well was (1) constructed, (2) reconstructed, or (3) plugged under my jurisdiction and was completed on (mo/day/year) 5-13-96 and this record is true to the best of my knowledge and belief. Kansas Water Well Contractor's License No. 572 This Water Well Record was completed on (mo/day/yr) 6-1-96 under the business name of Ashland Well Service Inc. by (signature) See Draft