USE TYPEWRITER OR BALL POINT PEN-PRESS FIRMLY, PRINT CLEARLY.

SITKA

WATER WELL RECORD
KSA 82a-1201-1215

CCC

Kansas Department of Health and Environment-Division of Environment
(Water well Contractors)
Topeka, Kansas 66620

1. Location of well:	County	Fraction	Section number	Township number	Range number
	Clark	SW 1/4 SW 1/4 SW 1/4	23	T 33 S	R 22 E/W

2. Distance and direction from nearest town or city: 4 miles EAST 2 South of Ashland, Kansas
Street address of well location if in city:

3. Owner of well: Frank Wasinger
R.R. or street: RFD
City, state, zip code: Ashland, Kansas 67831

4. Locate with "X" in section below:

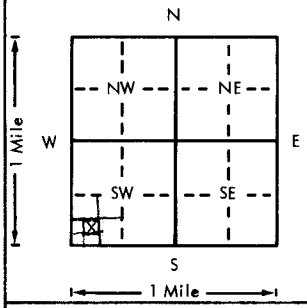

Sketch map:

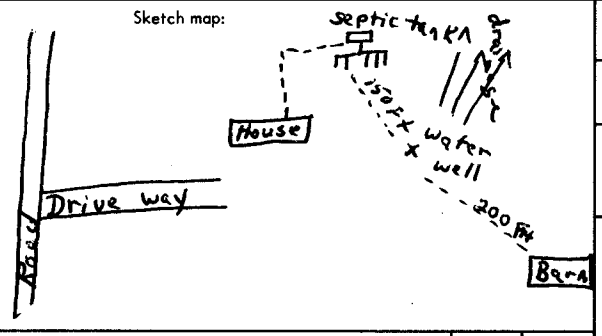

6. Bore hole dia. 9.75 in. Completion date
Well depth 140 ft. 5-25-77

7. __ Cable tool X Rotary __ Driven __ Dug
__ Hollow rod __ Jetted __ Bored __ Reverse rotary

8. Use: X Domestic __ Public supply __ Industry
__ Irrigation __ Air conditioning __ Stock
__ Lawn __ Oil field water __ Other

9. Casing: Material plts Height: Above or below
Threaded __ Welded gl Surface 18 in.
RMP X PVC __ Weight 1.8 lbs./ft.
Dia. 5 in. to 140 ft. depth Wall Thickness: inches or
Dia. __ in. to __ ft. depth gage No. 0.250

10. Screen: Manufacturer's name Jess and Lowell
Type RMP Dia. 5 in.
Slot/gauze .06 Length 30 ft.
Set between 110 ft. and 140 ft.
__ ft. and __ ft.
Gravel pack? yes Size range of material 1/4 1/8

11. Static water level: mo./day/yr.
20 ft. below land surface Date 5-25-77

12. Pumping level below land surfaces:
__ ft. after __ hrs. pumping __ g.p.m.
__ ft. after __ hrs. pumping __ g.p.m.
Estimated maximum yield __ g.p.m.

13. Water sample submitted: mo./day/yr.
__ Yes X No Date

14. Well head completion: nc
__ Pitless adapter __ Inches above grade

15. Well grouted? yes
With: X Neat cement __ Bentonite __ Concrete
Depth: From 0 ft. to 13 ft.

16. Nearest source of possible contamination: Septic
ft. 150 Direction N Type tank
Well disinfected upon completion? X Yes __ No

17. Pump: X Not installed
Manufacturer's name
Model number HP Volts
Length of drop pipe ft. capacity g.p.m.
Type:
__ Submersible __ Turbine
__ Jet __ Reciprocating
__ Centrifugal __ Other

5. Type and color of material	From	To
Surface	0	3
Fine sand and sandy brown clay	3	20
Red clay and red bed with rock stin	20	114
gers		
Sand rock and liver mud 5% clay	114	140
~~Red bed~~	140	
BRock 20'		
20		
0 salt		
Alluvium		

(Use a second sheet if needed)

18. Elevation:
Topography:
__ Hill
X Slope
__ Upland
__ Valley

19. Remarks:
1010
1916
20
1898

20. Water well contractor's certification:
This well was drilled under my jurisdiction and this report is true to the best of my knowledge and belief.
Hodde Drilling Co 302
Business name License No.
Address R.R. #1 Dodge City, Ks.
Signed Willis Hodde Jr. Date 6-15-77
Authorized representative

T 33 R 22 E Sec 23 1/4 SW SW SW

Forward the white, blue and pink copies to the Department of Health and Environment

Form WWC-5

MI-1023