


1 LOCATION OF WATER WELL: County: **CLARK** Fraction: **NW 1/4 SE 1/4** Section Number: **4** Township Number: **T 33 S** Range Number: **R 23 E**

Distance and direction from nearest town or city street address of well if located within city? **3 1/2 miles west 1/2 North of Ashland, KS**

2 WATER WELL OWNER: **Bill Brodie**
 RR#, St. Address, Box #: **Box 583** City, State, ZIP Code: **Ashland Kansas 67831**
 Board of Agriculture, Division of Water Resources Application Number:

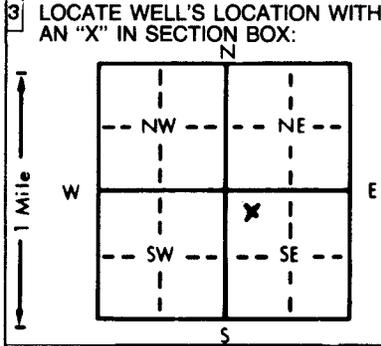

4 DEPTH OF COMPLETED WELL: **125** ft. ELEVATION: ft.
 Depth(s) Groundwater Encountered 1. **111** ft. 2. ft. 3. ft.
 WELL'S STATIC WATER LEVEL: **60** ft. below land surface measured on mo/day/yr **9-16-86**
 Pump test data: Well water was ft. after hours pumping gpm
 Est. Yield: **5** gpm; Well water was ft. after hours pumping gpm
 Bore Hole Diameter: **9** in. to **125** ft., and in. to ft.
 WELL WATER TO BE USED AS:
 1 Domestic 3 Feedlot 6 Oil field water supply 9 Dewatering 12 Other (Specify below) **livestock**
 2 Irrigation 4 Industrial 7 Lawn and garden only 10 Observation well
 Was a chemical/bacteriological sample submitted to Department? Yes.....No..... If yes, mo/day/yr sample was submitted
 Water Well Disinfected? Yes.....No.....

5 TYPE OF BLANK CASING USED:
 1 Steel 3 RMP (SR) 5 Wrought iron 8 Concrete tile CASING JOINTS: Glued Clamped
 2 PVC 4 ABS 6 Asbestos-Cement 9 Other (specify below) Welded
 Blank casing diameter: **5** in. to **105** ft. Dia. in. to ft. Dia. in. to ft.
 Casing height above land surface: **18** in., weight **287.3** lbs./ft. Wall thickness or gauge No. **265**
 TYPE OF SCREEN OR PERFORATION MATERIAL:
 1 Steel 3 Stainless steel 5 Fiberglass 8 RMP (SR) 10 Asbestos-cement
 2 Brass 4 Galvanized steel 6 Concrete tile 9 ABS 11 Other (specify)
 SCREEN OR PERFORATION OPENINGS ARE:
 1 Continuous slot 3 Mill slot 5 Gauzed wrapped ~~6 Wire wrapped~~ 11 None (open hole)
 2 Louvered shutter 4 Key punched 7 Torch cut 9 Drilled holes
 SCREEN-PERFORATED INTERVALS: From **105** ft. to **125** ft., From ft. to ft.
 GRAVEL PACK INTERVALS: From **10** ft. to **125** ft., From ft. to ft.

6 GROUT MATERIAL: 1 Neat cement 2 Cement grout 3 Bentonite 4 Other
 Grout Intervals: From **0** ft. to **14** ft., From ft. to ft., From ft. to ft.
 What is the nearest source of possible contamination:
 1 Septic tank 4 Lateral lines 7 Pit privy 10 Livestock pens **14 Abandoned water well**
 2 Sewer lines 5 Cess pool 8 Sewage lagoon 11 Fuel storage 15 Oil well/Gas well
 3 Watertight sewer lines 6 Seepage pit 9 Feedyard 12 Fertilizer storage 16 Other (specify below)
 13 Insecticide storage
 Direction from well? **WEST** How many feet? **8**

FROM	TO	LITHOLOGIC LOG	FROM	TO	LITHOLOGIC LOG
0	16	RED & LOAM MIX			
17	110	RED ROCK			
111	115	RED WATER SHALE			
116	125	RED ROCK			

7 CONTRACTOR'S OR LANDOWNER'S CERTIFICATION: This water well was (1) constructed, (2) reconstructed, or (3) plugged under my jurisdiction and was completed on (mo/day/year) **9-16-86** and this record is true to the best of my knowledge and belief. Kansas Water Well Contractor's License No. **411** This Water Well Record was completed on (mo/day/yr) **9-23-86** under the business name of **Leh's WATER WELL SERVICE** (signature) **Ronald C Leh**

INSTRUCTIONS: Use typewriter or ball point pen, PLEASE PRESS FIRMLY and PRINT clearly. Please fill in blanks, underline or circle the correct answers. Send top three copies to Kansas Department of Health and Environment, Division of Environment, Environmental Geology Section, Topeka, KS 66620. Send one to WATER WELL OWNER and retain one for your records.

OFFICE USE ONLY
T
R
EW
SEC.