


1 LOCATION OF WATER WELL: County: Clark Fraction: NW 1/4 NE 1/4 NW 1/4 Section Number: 11 Township Number: T 33 S Range Number: R 23 E (W)

Distance and direction from nearest town or city street address of well (if located within city): 3/4 mi west of Ashland, Ks on south side of Highway 160

2 WATER WELL OWNER: Jim Bisel Board of Agriculture, Division of Water Resources
 RR#, St. Address, Box #: Ashland, Kans. 67831 Application Number:
 City, State, ZIP Code

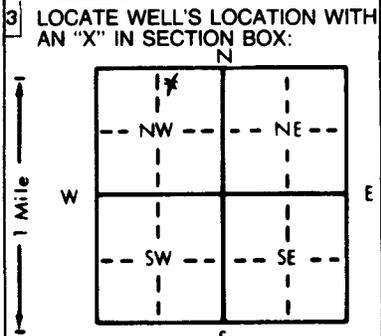

4 DEPTH OF COMPLETED WELL: 144 ft. ELEVATION:
 Depth(s) Groundwater Encountered 1. 75 ft. 2. 97 ft. 3. 135 ft.
 WELL'S STATIC WATER LEVEL: 6.5 ft. below land surface measured on 6-3-94 mo/day/yr
 Pump test data: Well water was 126 ft. after 2 hours pumping 5 gpm
 Est. Yield 5.6 gpm: Well water was _____ ft. after _____ hours pumping _____ gpm
 Bore Hole Diameter: 7 in. to 144 ft., and _____ in. to _____ ft.
 WELL WATER TO BE USED AS:
 1 Domestic 3 Feedlot 6 Oil field water supply 9 Dewatering 11 Injection well
 2 Irrigation 4 Industrial 7 Lawn and garden only 10 Monitoring well
 Was a chemical/bacteriological sample submitted to Department? Yes No
 Water Well Disinfected? Yes No

5 TYPE OF BLANK CASING USED:
 1 Steel 3 RMP (SR) 6 Asbestos-Cement 9 Other (specify below) Welded
 2 PVC 4 ABS 7 Fiberglass Threaded
 Blank casing diameter: 5 in. to 75 ft., Dia. _____ in. to _____ ft., Dia. _____ in. to _____ ft.
 Casing height above land surface: 24 in., weight: 2.87 lbs./ft. Wall thickness or gauge No. SOR 21
 TYPE OF SCREEN OR PERFORATION MATERIAL:
 7 PVC 10 Asbestos-cement 200 PSI
 1 Steel 3 Stainless steel 5 Fiberglass 8 RMP (SR) 11 Other (specify) _____
 2 Brass 4 Galvanized steel 6 Concrete tile 9 ABS 12 None used (open hole)
 SCREEN OR PERFORATION OPENINGS ARE:
 8 Saw cut 11 None (open hole)
 1 Continuous slot 3 Mill slot 6 Wire wrapped 9 Drilled holes
 2 Louvered shutter 4 Key punched 7 Torch cut 10 Other (specify) _____
 SCREEN-PERFORATED INTERVALS: From 75 ft. to 100 ft., From 120 ft. to 144 ft.
 From _____ ft. to _____ ft., From _____ ft. to _____ ft.
 GRAVEL PACK INTERVALS: From 110 ft. to 144 ft., From _____ ft. to _____ ft.
 From 70 ft. to 100 ft., From _____ ft. to _____ ft.

6 GROUT MATERIAL: 1 Neat cement 2 Cement grout 3 Bentonite 4 Other _____
 Grout intervals: From 100 ft. to 110 ft., From 30 ft. to 3 ft., From _____ ft. to _____ ft.
 What is the nearest source of possible contamination:
 1 Septic tank 4 Lateral lines 7 Pit privy 10 Livestock pens 14 Abandoned water well
 2 Sewer lines 5 Cess pool 8 Sewage lagoon 11 Fuel storage 15 Oil well/Gas well
 3 Watertight sewer lines 6 Seepage pit 9 Feedyard 12 Fertilizer storage 16 Other (specify below) 150 ft. south of Highway
 Direction from well? _____ How many feet? _____

FROM	TO	LITHOLOGIC LOG	FROM	TO	PLUGGING INTERVALS
0	3	Topsoil and small rocks			
3	28	small rock, clay & red			
28	57	mixture of red clays various hardness (shales)			
57	75	clay - red & white			
75	96	soad gravel, fine, fine			
97	108	sand & red clay			
108	134	clay and shale - red			
135	140	fine sand, clay - red			
140	144	clay - hard - red			

7 CONTRACTOR'S OR LANDOWNER'S CERTIFICATION: This water well was (1) constructed, (2) reconstructed, or (3) plugged under my jurisdiction and was completed on (mo/day/year) 6-3-94 and this record is true to the best of my knowledge and belief. Kansas Water Well Contractor's License No. 572A This Water Well Record was completed on (mo/day/yr) 6-8-94 under the business name of Ashland Well Service Inc. by (signature) Dee Duff

OFFICE USE ONLY
T
R
EW
SEC.