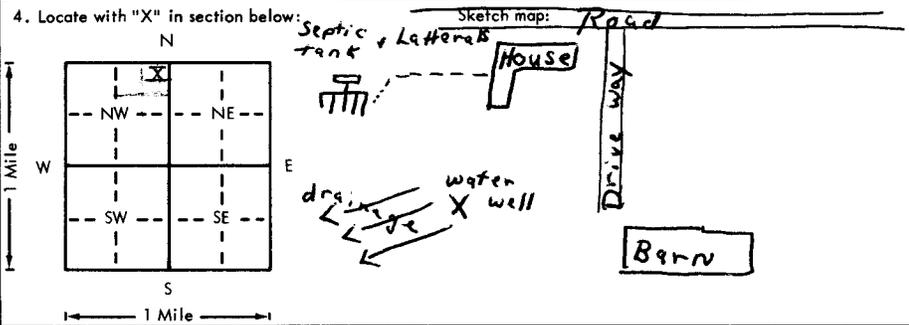


USE TYPEWRITER OR BALL POINT PEN-PRESS FIRMLY, PRINT CLEARLY.

WATER WELL RECORD
KSA 82a-1201-1215

Kansas Department of Health and Environment-Division of Environment
(Water well Contractors)
Topeka, Kansas 66620

A A
B B B

1. Location of well: County Clark		Fraction NE NE NW NW NW NW 1/4 1/4 1/4 1/4		Section number 23	Township number T 33 S R 23	Range number 23
2. Distance and direction from nearest town or city: 1.5 miles South, Southwest of Ashland, Kansas				3. Owner of well: George C. Berryman R.R. or street: Box 25 City, state, zip code: Ashland, Kansas 67831		
4. Locate with "X" in section below: 				6. Bore hole dia. 9.75 in. Completion date June 2, 1977 Well depth 52 ft.		
5. Type and color of material				7. <input checked="" type="checkbox"/> Cable tool <input checked="" type="checkbox"/> Rotary <input type="checkbox"/> Driven <input type="checkbox"/> Dug <input type="checkbox"/> Hollow rod <input type="checkbox"/> Jetted <input type="checkbox"/> Bored <input type="checkbox"/> Reverse rotary		
Surface				8. Use: <input checked="" type="checkbox"/> Domestic <input type="checkbox"/> Public supply <input type="checkbox"/> Industry <input type="checkbox"/> Irrigation <input type="checkbox"/> Air conditioning <input type="checkbox"/> Stock <input type="checkbox"/> Lawn <input type="checkbox"/> Oil field water <input type="checkbox"/> Other		
Red clay				9. Casing: Material pipes Height Above or below Threading Welded Surface 18 in. RMP <input checked="" type="checkbox"/> PVC Weight 1.8 lbs./ft. Dia. 5 in. to 52 ft. depth Wall Thickness: inches or Dia. 0.250 in. to 0.250 ft. depth gage No. 0.250		
Medium sand and gravel				10. Screen: Manufacturer's name Jess and Lowell Type RMP Dia. 5 in. Slot/gauze .06 Length 30 ft. Set between 22 ft. and 52 ft. Gravel pack? <input checked="" type="checkbox"/> Size range of material 1/4 - 1/8		
Red bed				11. Static water level: 24 ft. below land surface Date 6-2-77 mo./day/yr.		
BROCK 45'				12. Pumping level below land surfaces: ____ ft. after ____ hrs. pumping ____ g.p.m. ____ ft. after ____ hrs. pumping ____ g.p.m. Estimated maximum yield ____ g.p.m.		
24' 21' sand thick				13. Water sample submitted: ____ mo./day/yr. Yes <input type="checkbox"/> No <input checked="" type="checkbox"/> Date		
Alluvium				14. Well head completion: NC <input type="checkbox"/> Pitless adapter ____ Inches above grade		
(Use a second sheet if needed)				15. Well grouted? yes With <input checked="" type="checkbox"/> Neat cement <input type="checkbox"/> Bentonite <input type="checkbox"/> Concrete Depth: From 0 ft. to 13 ft.		
18. Elevation:				16. Nearest source of possible contamination: septic tank ft. 125 Direction NW Type tank Well disinfected upon completion? <input checked="" type="checkbox"/> Yes <input type="checkbox"/> No		
19. Remarks:				17. Pump: <input checked="" type="checkbox"/> Not installed Manufacturer's name ____ Model number ____ HP ____ Volts ____ Length of drop pipe ____ ft. capacity ____ g.p.m. Type: <input type="checkbox"/> Submersible <input type="checkbox"/> Turbine <input type="checkbox"/> Jet <input type="checkbox"/> Reciprocating <input type="checkbox"/> Centrifugal <input type="checkbox"/> Other		
Topography: <input type="checkbox"/> Hill <input checked="" type="checkbox"/> Slope <input type="checkbox"/> Upland <input type="checkbox"/> Valley				20. Water well contractor's certification: This well was drilled under my jurisdiction and this report is true to the best of my knowledge and belief. Hodde Drilling Co. 302 Business name License No. ____ Address RR 1 Dodge City, Ks Signed Walter Hodde Jr Date 6-15-77 Authorized representative		

33 230 23
Sec 1/4 1/4 1/4
NEW NE ALLI