

SE SE SW dri


**WATER WELL PLUGGING RECORD Form WWC-5P KSA 82a-1212 ID NO.**

<b>1 LOCATION OF WATER WELL:</b> County: <u>Clark</u>	Fraction <u>SW 1/4 SE 1/4 SE 1/4</u>	Section Number <u>21</u>	Township Number <u>33</u>	Range Number <u>24 E</u>
--	---	-----------------------------	------------------------------	-----------------------------

Distance and direction from nearest town or city street address of well if located within city?

7N + 2 1/2 E from Englewood

<b>2 WATER WELL OWNER:</b> <u>Mike McCarty</u> RR#, St. Address, Box #: City, State ZIP Code: <u>Askland, KS 67831</u>	<b>Global Positioning Systems</b> (decimal degrees, min. of 4 digits) Latitude: _____ Longitude: _____ Elevation: _____ Datum: _____ Data Collection Method: _____
--	---

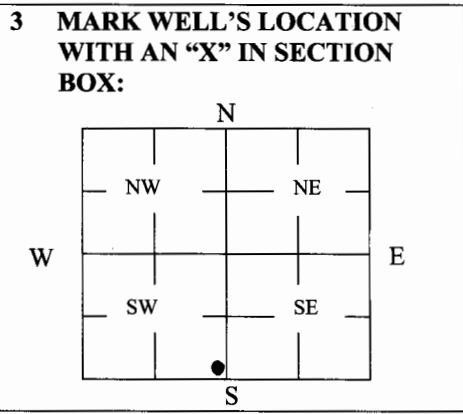

**4 DEPTH OF WELL** 54 ft.  
WELL'S STATIC WATER LEVEL 24 ft.  
WELL WAS USED AS:  
 Domestic      5 Public Water Supply      9 Dewatering  
2 Irrigation      6 Oil Field Water Supply      10 Monitoring  
3 Feedlot      7 Domestic (Lawn & Garden)      11 Injection Well  
4 Industrial      8 Air Conditioning      12 Other \_\_\_\_\_  
Was a chemical/bacteriological sample submitted to Department? Yes \_\_\_\_\_ No

**5 TYPE OF BLANK CASING USED:**  
1 Steel      3 RMP (SR)      5 Wrought      7 Fiberglass      9 Other (Specify below)  
 PVC      4 ABS      6 Asbestos-Cement      8 Concrete Tile

Blank casing diameter 4 in. Was casing pulled? Yes \_\_\_\_\_ No  If yes, how much \_\_\_\_\_  
Casing height above or below land surface 36 in.

**6 GROUT PLUG MATERIAL:**      1 Neat cement      2 Cement grout       Bentonite      4 Other \_\_\_\_\_

Grout Plug Intervals: From 54 ft. to 3 ft., From \_\_\_\_\_ ft. to \_\_\_\_\_ ft., From \_\_\_\_\_ to \_\_\_\_\_ ft.

What is the nearest source of possible contamination:  
1 Septic tank      6 Seepage pit      11 Fuel Storage       Other (specify below) New well  
2 Sewer lines      7 Pit privy      12 Fertilizer storage  
3 Watertight sewer lines      8 Sewage lagoon      13 Insecticide storage  
4 Lateral lines      9 Feedyard      14 Abandoned water well      Direction from well? S  
5 Cess pool      10 Livestock pens      15 Oil well/Gas well      How many feet? 100

FROM	TO	PLUGGING MATERIALS	FROM	TO	PLUGGING MATERIALS
<u>54</u>	<u>3</u>	<u>bentonite chips</u>			
<u>3</u>	<u>0</u>	<u>back filled and leveled</u>			

**7 CONTRACTOR'S OR LANDOWNER'S CERTIFICATION:** This water well was plugged under my jurisdiction and was completed on (mo/day/year) 6-27-07 and this record is true to the best of my knowledge and belief. Kansas Water Well Contractor's License No. 101. This Water Well Record was completed on (mo/day/year) 6-30-07 under the business name of Bartel Well Drilling, Inc. by (signature) Reuben J. Bartel

**INSTRUCTIONS:** Use typewriter or ballpoint pen. Please press firmly and print clearly. Please fill in blanks, underline or circle the correct answers. Send top three copies to Kansas Department of Health and Environment, Bureau of Water, Geology Section, 1000 SW Jackson St., Ste. 420, Topeka, Kansas 66612-1367. Telephone: 785/296-5522. Send one to Water Well Owner and retain one for your records. Visit us at <http://www.kdheks.gov/geo/waterwells>.