

CORRECTION(S) TO WATER WELL RECORD (WWC-5)

(to rectify lacking or incorrect information)

County: Clark

Location listed as:

Section-Township-Range: 10-33S-24E

Fraction (1/4 1/4 1/4): SW NE SW

Location changed to:

10-33S-24W

SW NE SW

Other changes: Initial statements: _____

Changed to: _____

Comments: _____

verification method: Written & legal descriptions, county ownership map, position on plat map, and mapping tool & aerial photo on KGS website. initials: ORL date: 4/14/2009

submitted by: Kansas Geological Survey, Data Resources Library, 1930 Constant Ave., Lawrence, KS 66047-3726
to: Kansas Dept of Health & Environment, Bureau of Water, 1000 SW Jackson, Suite 420, Topeka, KS 66612-1367.


WATER WELL RECORD Form WWC-5 KSA 82a-1212

1 LOCATION OF WATER WELL: Fraction Section Number Township Number Range Number
 COUNTY: CLARK SW 1/4 NE 1/4 SW 1/4 10 T 33 S R 24 E

Distance and direction from nearest town or city street address of well if located within city?
 FROM ENGLEWOOD - 9 MILES NORTH ON HIGHWAY 283 -4 1/2 EAST

2 WATER WELL OWNER: COX, JAMES - WELL #3 Board of Agriculture, Division of Water Resources
 RR#, St. Address, Box #: 1281 CRW Application Number:
 City, State, ZIP code: ASHLAND, KS 67831-

3 LOCATE WELL'S LOCATION WITH AN "X" IN SECTION BOX:

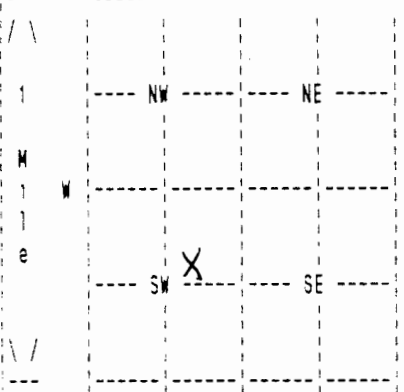

4 DEPTH OF COMPLETED WELL 125 ELEVATION: 0
 Depth(s) Groundwater Encountered 1. 0 ft. 2. 0 ft. 3. 0 ft.

WELL'S STATIC WATER LEVEL 31 ft. below land surface measured on mo/day/yr 06/20/08
 Pump testdata: Well water was 0 ft. after 0 hours pumping 0 gpm

Estimated Yield 20 gpm: Well water was 0 ft. after 0 hours pumping 0 gpm

Bore Hole Diameter 10 in. to 125 ft., and in. to 0 ft.

WELL WATER TO BE USED AS: DOMESTIC

Was a chemical/bacteriological sample submitted to department? No ;
 If yes, mo/day/yr sample was submitted Water well disinfected? Yes

5 TYPE OF BLANK CASING USED: CERTA LOC CASIN CASING JOINTS: CERTA-LOC
 Blank casing diameter 5 in. to 125 ft., Dia in. to 0 ft., Dia in. to 0 ft.
 Casing height above land surface 12 in., weight 200 lbs/ft. Wall thickness or gauge No. 21
 TYPE OF SCREEN OR PERFORATION MATERIAL: PVC
 SCREEN OR PERFORATION OPENINGS ARE: SAW CUT

SCREEN PERFORATED INTERVALS: From 60 ft. to 120 ft., From 0 ft. to 0 ft.
 From 0 ft. to 0 ft., From 0 ft. to 0 ft.
 GRAVEL PACK INTERVALS: From 20 ft. to 125 ft., From 0 ft. to 0 ft.
 From 0 ft. to 0 ft., From 0 ft. to 0 ft.

6 GROUT MATERIAL BENTONITE
 Grout Intervals: From 0 ft. to 20 ft., From 0 ft. to 0 ft., From 0 ft. to 0 ft.
 What is the nearest source of possible contamination: NONE
 Direction from well? How many feet? 0

FROM	TO	LITHOLOGIC LOG	FROM	TO	PLUGGING INTERVALS
0	20	01 TOPSOIL 11 BROWN CLAY 37 FIN-COAR SAN			
20	40	26 RED CLAY			
40	60	26 RED CLAY 29 SANDSTONE			
60	80	28 SAND 29 SANDSTONE 26 RED CLAY			
80	100	26 RED CLAY 29 SANDSTONE 19 LAYERS			
100	120	29 SANDSTONE 26 RED CLAY			
120	140	26 RED CLAY 08 ROCK LAYERS			

7 CONTRACTOR'S OR LANDOWNER'S CERTIFICATION: This water well was Constructed under my jurisdiction and was completed on (mo/day/year) 06/20/08 and this record is true to the best of my knowledge and belief. Kansas Water Well Contractor's License No. 179 This Water Well Record was completed on (mo/day/yr) 07/11/08 under the business name of JOE'S WELL SERVICE, INC. by (signature) *Joel Calk*