


1 LOCATION OF WATER WELL: County: **CLARK** Fraction: **SW 1/4 SW 1/4 NE 1/4** Section Number: **7** Township Number: **T 33 0** Range Number: **R 24 E0**

Distance and direction from nearest town or city street address of well if located within city?  
**FROM ASHLAND 1 1/2 WEST AND 1/2 MILE SOUTH**

2 WATER WELL OWNER: **MERTON MOORMAN**  
 RR#, St. Address, Box #: **MINEOLA, KANSAS**  
 City, State, ZIP Code: **MINEOLA, KANSAS**  
 Board of Agriculture, Division of Water Resources Application Number:

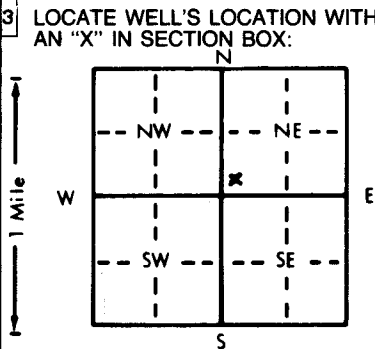

4 DEPTH OF COMPLETED WELL: **135** ft. ELEVATION:  
 Depth(s) Groundwater Encountered 1. **102** ft. 2. ft. 3. ft.  
 WELL'S STATIC WATER LEVEL: **65** ft. below land surface measured on mo/day/yr **9-14-84**  
 Pump test data: Well water was ft. after hours pumping gpm  
 Est. Yield **1.5** gpm: Well water was ft. after hours pumping gpm  
 Bore Hole Diameter: **9** in. to **135** ft., and in. to ft.  
 WELL WATER TO BE USED AS: 5 Public water supply 8 Air conditioning 11 Injection well  
 Domestic 3 Feedlot 6 Oil field water supply 9 Dewatering  Other (Specify below)  
 2 Irrigation 4 Industrial 7 Lawn and garden only 10 Observation well **Stock**  
 Was a chemical/bacteriological sample submitted to Department? Yes.....No. ; If yes, mo/day/yr sample was submitted  
 Water Well Disinfected? Yes

5 TYPE OF BLANK CASING USED: 5 Wrought iron 8 Concrete tile CASING JOINTS: Glued  Clamped  
 1 Steel 3 RMP (SR) 6 Asbestos-Cement 9 Other (specify below) Welded  
 PVC 4 ABS 7 Fiberglass Threaded  
 Blank casing diameter: **5** in. to **100** ft., Dia. **5** in. to **135** ft., Dia. in. to ft.  
 Casing height above land surface: **18** in., weight **2.97** lbs./ft. Wall thickness or gauge No. **2.65**

TYPE OF SCREEN OR PERFORATION MATERIAL:  PVC 10 Asbestos-cement  
 1 Steel 3 Stainless steel 5 Fiberglass 8 RMP (SR) 11 Other (specify)  
 2 Brass 4 Galvanized steel 6 Concrete tile 9 ABS 12 None used (open hole)  
 SCREEN OR PERFORATION OPENINGS ARE: 5 Gauzed wrapped 8 Saw cut 11 None (open hole)  
 1 Continuous slot  Mill slot 6 Wire wrapped 9 Drilled holes  
 2 Louvered shutter 4 Key punched 7 Torch cut 10 Other (specify)

SCREEN-PERFORATED INTERVALS: From **101** ft. to **120** ft., From ft. to ft.  
 From ft. to ft., From ft. to ft.  
 GRAVEL PACK INTERVALS: From **10** ft. to **135** ft., From ft. to ft.  
 From ft. to ft., From ft. to ft.

6 GROUT MATERIAL: 1 Neat cement  Cement grout 3 Bentonite 4 Other  
 Grout Intervals: From **0** ft. to **10** ft., From ft. to ft., From ft. to ft.  
 What is the nearest source of possible contamination: 10 Livestock pens  Abandoned water well  
 1 Septic tank 4 Lateral lines 7 Pit privy 11 Fuel storage 15 Oil well/Gas well  
 2 Sewer lines 5 Cess pool 8 Sewage lagoon 12 Fertilizer storage 16 Other (specify below)  
 3 Watertight sewer lines 6 Seepage pit 9 Feedyard 13 Insecticide storage  
 Direction from well? **NORTH WEST** How many feet? **80'**

FROM	TO	LITHOLOGIC LOG	FROM	TO	LITHOLOGIC LOG
0	100	RED CLAY & ROCK			
101	119	SHALE & LIGHT GRAVEL			
120	135	RED CLAY & ROCK			

7 CONTRACTOR'S OR LANDOWNER'S CERTIFICATION: This water well was (1)  constructed, (2) reconstructed, or (3) plugged under my jurisdiction and was completed on (mo/day/year) **9-14-84** and this record is true to the best of my knowledge and belief. Kansas Water Well Contractor's License No. **411** This Water Well Record was completed on (mo/day/yr) **10-29-84** under the business name of **LEH'S WATER WELL SERVICE** by (signature) **Ronald C. Leh**  
 INSTRUCTIONS: Use typewriter or ball point pen, PLEASE PRESS FIRMLY and PRINT clearly. Please fill in blanks, underline or circle the correct answers. Send top three copies to Kansas Department of Health and Environment, Division of Environment, Environmental Geology Section, Topeka, KS 66620. Send one to WATER WELL OWNER and retain one for your records.

OFFICE USE ONLY T R E W SEC.