USE TYPEWRITER OR BALL POINT PEN-PRESS FIRMLY, PRINT CLEARLY.

ASHLAND NW

WATER WELL RECORD
KSA 82a-1201-1215

Kansas Department of Health and Environment-Division of Environment
(Water well Contractors)
Topeka, Kansas 66620

1. Location of well:	County	Fraction	Section number	Township number	Range number
	Clark	SE ~~NW~~ 1/4 SE ~~SE~~ 1/4 NW ~~SE~~ 1/4	36	T 33 S	R 25 E/W

2. Distance and direction from nearest town or city: 6 mi. N of Englewood
Street address of well location if in city: home: 1 mi. N, 3½ mi. W

3. Owner of well: ~~Harry Baker~~ Mrs. Ern Rinehart
R.R. or street:
City, state, zip code: Englewood, Kansas

4. Locate with "X" in section below: Sketch map:

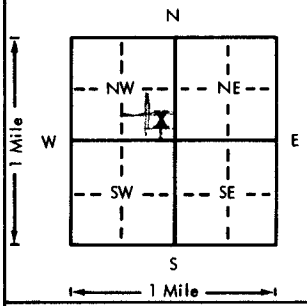

6. Bore hole dia. 9 7/8 in. Completion date _____
Well depth 67 ft. 3-24-76

7. __ Cable tool X Rotary __ Driven __ Dug
__ Hollow rod __ Jetted __ Bored __ Reverse rotary

8. Use: __ Domestic __ Public supply __ Industry
__ Irrigation __ Air conditioning X Stock
__ Lawn __ Oil field water __ Other

9. Casing: Material PVC Height: (Above) or below MNC
Threaded ___ Welded X Surface 12 in.
RMP ___ PVC ___ Weight 291 lbs./ft. 100
Dia. 5 in. to 67 ft. depth Wall Thickness: inches or
Dia. ___ in. to ___ ft. depth gage No. .265

5. Type and color of material	From	To
Top soil	0	4
Clay	4	21
Med. sand	21	28
Tan and blue clay (sand streaks)	28	52
Med. sand	52	65
Clay with sand streaks	65	70
BROCK ?		

(Use a second sheet if needed)

10. Screen: Manufacturer's name Jess & Lowell
Type PVC Dia. 5"
Slot/gauze 1/8" Length 30'
Set between 37 ft. and 67 ft.
___ ft. and ___ ft.
Gravel pack? yes Size range of material 3/16"

11. Static water level: mo./day/yr.
19 ft. below land surface Date 3/12/76

12. Pumping level below land surfaces:
___ ft. after ___ hrs. pumping ___ g.p.m.
___ ft. after ___ hrs. pumping ___ g.p.m.
Estimated maximum yield ___ g.p.m.

13. Water sample submitted: mo./day/yr.
__ Yes X No Date ___

14. Well head completion:
__ Pitless adapter 12 Inches above grade

15. Well grouted? yes
With: __ Neat cement __ Bentonite X Concrete
Depth: From 0 ft. to 10 ft.

16. Nearest source of possible contamination:
ft. 15 Direction east Type old well
Well disinfected upon completion? X Yes __ No

17. Pump: Windmill __ Not installed
Manufacturer's name ___
Model number ___ HP ___ Volts ___
Length of drop pipe 31 ft. capacity 3 g.p.m.
Type:
__ Submersible __ Turbine
__ Jet __ Reciprocating
__ Centrifugal __ Other

18. Elevation:
Topography:
__ Hill
__ Slope
__ Upland
X Valley

19. Remarks:
TOPO
2024

20. Water well contractor's certification:
This well was drilled under my jurisdiction and this report is true to the best of my knowledge and belief.
Business name Friesen Windmill License No. 252
Address Meade, Kansas 67864
Signed [signature] Date 1-4-80
Owner or Representative

T 33 R 25 (W) E Sec 36 SE SE NW 1/4 1/4 1/4

Forward the white, blue and pink copies to the Department of Health and Environment

Form WWC-5

MI-1023