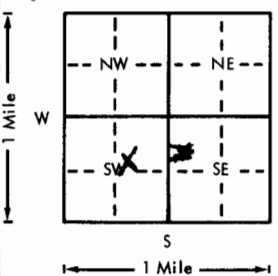
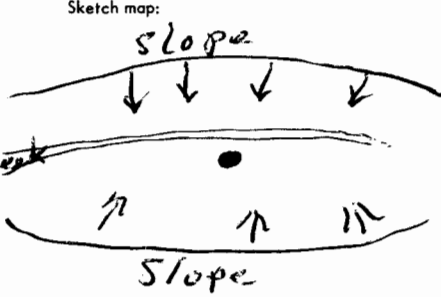


USE TYPEWRITER OR BALL  
POINT PEN-PRESS FIRMLY,  
PRINT CLEARLY.

WATER WELL RECORD  
KSA 82a-1201-1215

Kansas Department of Health and  
Environment-Division of Environment  
(Water well Contractors)  
Topeka, Kansas 66620

1. Location of well:		County <b>Meade</b>	Fraction <del>SE 1/4</del> <b>NW 1/4 SW 1/4 NE 1/4 SW 1/4</b>	Section number <b>34</b>	Township number <b>T 33 S</b>	Range number <b>R 26 E</b>
2. Distance and direction from nearest town or city: <b>12 miles S 11 miles E</b>				3. Owner of well: <b>Joe Woodruff</b>		
Street address of well location if in city:				City, state, zip code: <b>Meade Kansas 67864</b>		
X Locate with "X" in section below:		Sketch map:		6. Bore hole dia. <b>8 3/4</b> in. Completion date <b>3-18-91</b> Well depth <b>80</b> ft.		
				7. Cable tool <input checked="" type="checkbox"/> Rotary <input type="checkbox"/> Driven <input type="checkbox"/> Dug <input type="checkbox"/> Hollow rod <input type="checkbox"/> Jetted <input type="checkbox"/> Bored <input type="checkbox"/> Reverse rotary		
5. Type and color of material		From		To		8. Use: <input type="checkbox"/> Domestic <input type="checkbox"/> Public supply <input type="checkbox"/> Industry <input type="checkbox"/> Irrigation <input type="checkbox"/> Air conditioning <input checked="" type="checkbox"/> Stock <input type="checkbox"/> Lawn <input type="checkbox"/> Oil field water <input type="checkbox"/> Other
Top Soil		0		5		9. Casing: Material <b>plastic</b> Height: Above or below Threaded <input type="checkbox"/> Welded <input checked="" type="checkbox"/> Surface <b>24</b> in. RMP <input type="checkbox"/> PVC <input type="checkbox"/> Weight <input type="checkbox"/> lbs./ft.
Sand Rock		5		40		Dia. <b>5</b> in. to <b>80</b> ft. depth Wall Thickness: inches or Dia. <input type="checkbox"/> in. to <input type="checkbox"/> ft. depth gage No. <b>320 well</b>
Clay		40		69		10. Screen: Manufacturer's name <b>Sam Flores plastic</b> Type <b>PVC</b> Dia. <b>5</b> Slot/gauze <b>1/16</b> Length <b>20</b> Set between <b>60</b> ft. and <b>80</b> ft. Gravel pack? <input checked="" type="checkbox"/> Size range of material <b>1/16 - 1/4</b>
Gravel		69		70		11. Static water level: <input type="checkbox"/> mo./day/yr. <b>42</b> ft. below land surface Date <input type="checkbox"/>
Clay (Red Bed)		70		80		12. Pumping level below land surfaces: ft. after <b>1 1/2</b> hrs. pumping <b>4</b> g.p.m. ft. after <input type="checkbox"/> hrs. pumping <input type="checkbox"/> g.p.m. Estimated maximum yield <b>4</b> g.p.m.
BR 70 4m						13. Water sample submitted: <input type="checkbox"/> mo./day/yr. Yes <input checked="" type="checkbox"/> No <input type="checkbox"/> Date <input type="checkbox"/>
						14. Well head completion: <input type="checkbox"/> Pitless adapter <input type="checkbox"/> inches above grade
						15. Well grouted? <input checked="" type="checkbox"/> With: <input type="checkbox"/> Neat cement <input type="checkbox"/> Bentonite <input checked="" type="checkbox"/> Concrete Depth: From <b>0</b> ft. to <b>10</b> ft.
						16. Nearest source of possible contamination: ft. <b>3500</b> Direction <b>North</b> Type <b>fuel &amp; cement</b> Well disinfected upon completion? <input type="checkbox"/> Yes <input checked="" type="checkbox"/> No
						17. Pump: <input type="checkbox"/> Not installed Manufacturer's name <input type="checkbox"/> Model number <input type="checkbox"/> HP <input type="checkbox"/> Volts <input type="checkbox"/> Length of drop pipe <input type="checkbox"/> ft. capacity <input type="checkbox"/> g.p.m. Type: <b>Windmill</b> <input type="checkbox"/> Submersible <input type="checkbox"/> Turbine <input type="checkbox"/> Jet <input type="checkbox"/> Reciprocating <input type="checkbox"/> Centrifugal <input type="checkbox"/> Other
18. Elevation: <b>2249</b> Topography: <b>h</b> <input type="checkbox"/> Hill <input checked="" type="checkbox"/> Slope <input type="checkbox"/> Upland <input type="checkbox"/> Valley		19. Remarks: <b>2249</b> <b>2207</b>		20. Water well contractor's certification: This well was drilled under my jurisdiction and this report is true to the best of my knowledge and belief. <b>Dale R Bantel</b> <b>101 A</b> Business name <b>meade ks</b> License No. <input type="checkbox"/> Address <b>meade ks</b> Signed <b>Dale R Bantel</b> Date <b>3-15-91</b> Authorized representative		

Forward the white, blue and pink copies to the Department of Health and Environment

Form WWC-5