

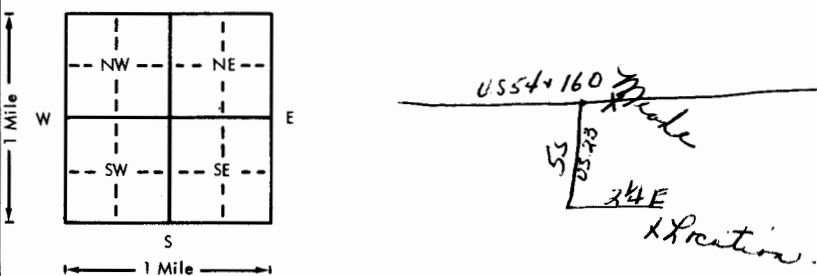
USE TYPEWRITER OR BALL
POINT PEN-PRESS FIRMLY,
PRINT CLEARLY.

WATER WELL RECORD
KSA 82a-1201-1215

Kansas Department of Health and
Environment-Division of Environment
(Water well Contractors)
Topeka, Kansas 66620

Weins 1-6

CWW Inv. # 12651

1. Location of well:	County Meade	Fraction Center East 1/2 1/4 1/4 1/4	Section number 6	Township number 33 T S R	Range number 27 E A W
2. Distance and direction from nearest town or city: 5 miles south of Meade, 2 1/4 east. Street address of well location if in city:		3. Owner of well: Sage Drilling Company Rig #2 R.R. or street: 500 Bitting Bldg. City, state, zip code: Wichita, Kansas 67202			
4. Locate with "X" in section below: N W E S 1 Mile Sketch map: 		6. Bore hole dia. 9 in. Completion date 9-2- Well depth 240 ft.			
5. Type and color of material		From	To	7. Cable tool <input checked="" type="checkbox"/> Rotary <input type="checkbox"/> Driven <input type="checkbox"/> Dug <input type="checkbox"/> Hollow rod <input type="checkbox"/> Jetted <input type="checkbox"/> Bored <input type="checkbox"/> Reverse rotary	
Surface		0	2	8. Use: <input type="checkbox"/> Domestic <input type="checkbox"/> Public supply <input type="checkbox"/> Industry <input type="checkbox"/> Irrigation <input type="checkbox"/> Air conditioning <input type="checkbox"/> Stock <input type="checkbox"/> Lawn <input checked="" type="checkbox"/> Oil field water <input type="checkbox"/> Other	
Sandy clay and caliche 60-40		2	22	9. Casing: Material <input type="checkbox"/> Height: Above or below Threaded <input type="checkbox"/> Welded <input type="checkbox"/> Surface 28 in. RMP <input type="checkbox"/> PVC <input checked="" type="checkbox"/> Weight 2.78 lbs./ft. Dia. 5 in. to 155 ft. depth Wall Thickness 1/8 in. or Dia. 5 in. to 240 ft. depth gage No. .265	
Fine sand		22	45	10. Screen: Manufacturer's name sawed perf. Type PVC Dia. 5 in. Slot/gauze 030 Length 80 Set between 155 ft. and 235 ft. yes ft. and 1/8 to 3/16 ft. Gravel pack? <input checked="" type="checkbox"/> Size range of material	
Fine sand and sandy clay 70-30		45	60	11. Static water level: 10 ft. below land surface Date 9-2-76	
Fine sand		60	120	12. Pumping level below land surfaces: ft. after hrs. pumping g.p.m. ft. after hrs. pumping g.p.m. Estimated maximum yield 60 g.p.m.	
Fine sand and sandy clay		120	175	13. Water sample submitted: <input checked="" type="checkbox"/> Yes <input type="checkbox"/> No Date	
Med. to large sand and sandy clay 80-20		175	240	14. Well head completion: <input type="checkbox"/> Pitless adapter 28 inches above grade	
				15. Well grouted? yes With: <input checked="" type="checkbox"/> Neat cement <input type="checkbox"/> Bentonite <input type="checkbox"/> Concrete Depth: From 0 ft. to 10 ft.	
				16. Nearest source of possible contamination: ft. 100 Direction NE Type oil well Well disinfected upon completion? <input checked="" type="checkbox"/> Yes <input type="checkbox"/> No	
				17. Pump: <input checked="" type="checkbox"/> Not installed Manufacturer's name Model number HP Volts Length of drop pipe ft. capacity g.p.m. Type: <input type="checkbox"/> Submersible <input type="checkbox"/> Turbine <input type="checkbox"/> Jet <input type="checkbox"/> Reciprocating <input type="checkbox"/> Centrifugal <input type="checkbox"/> Other	
18. Elevation:		19. Remarks:		20. Water well contractor's certification: This well was drilled under my jurisdiction and this report is true to the best of my knowledge and belief. Carlile Water Well 118 Business name Box 275, Liberal, KS. license No. Address Signed Edward E. Means Date 9-20 Authorized representative	

Forward the white, blue and pink copies to the Department of Health and Environment

Form WWC-5