

PERMIT #T-78-64

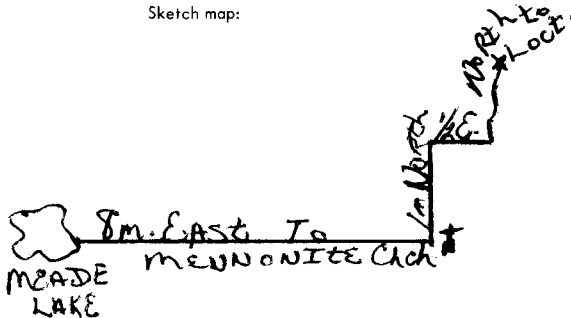
USE TYPEWRITER OR BALL
POINT PEN-PRESS FIRMLY,
PRINT CLEARLY.

WATER WELL RECORD
KSA 82a-1201-1215

Kansas Department of Health and
Environment-Division of Environment
(Water well Contractors)
Topeka, Kansas 66620

CWW Inv.#14483

Classen #1

1. Location of well:	County Meade	Fraction SE 1/4 NW 1/4 NW 1/4	Section number 9	Township number T 33S S R	Range number 27W E/W
2. Distance and direction from nearest town or city: From Go East of Meade 1k. 8m to Mennonite chch then 1m North 2m East - Follow Rd. North to location.			3. Owner of well: Diamond Shamrock Corp. R.R. or street: Star Rt.#1, Box 36 City, state, zip code: Sunray, Texas 79086		
4. Locate with "X" in section below: N W E S 1 Mile		Sketch map: 		6. Bore hole dia. 9 in. Completion date 3-30 Well depth 360 ft.	
		7. <input type="checkbox"/> Cable tool <input checked="" type="checkbox"/> Rotary <input type="checkbox"/> Driven <input type="checkbox"/> Dug <input type="checkbox"/> Hollow rod <input type="checkbox"/> Jetted <input type="checkbox"/> Bored <input type="checkbox"/> Reverse rotary		8. Use: <input type="checkbox"/> Domestic <input type="checkbox"/> Public supply <input checked="" type="checkbox"/> Industry <input type="checkbox"/> Irrigation <input type="checkbox"/> Air conditioning <input type="checkbox"/> Stock <input type="checkbox"/> Lawn <input checked="" type="checkbox"/> Oil field water <input type="checkbox"/> Other	
		9. Casing: Material <input type="checkbox"/> Threaded <input type="checkbox"/> Welded <input type="checkbox"/> Surface 28 in. RMP <input type="checkbox"/> PVC <input checked="" type="checkbox"/> Weight 2.78 lbs./ft. Dia. 5 in. to 275 ft. depth; Wall Thickness: inches or Dia. 5 in. to 360 ft. depth; gage No. 265		10. Screen: Manufacturer's name Sawed perf. Type PVC Dia. 5" Slot/gauze 80' Length 80' Set between 275 ft. and 355 ft. Gravel pack? yes Size range of material 1/8-3/16	
5. Type and color of material		From	To	11. Static water level: 105 ft. below land surface Date 3-30-78	
Surface		0	2	12. Pumping level below land surfaces: ____ ft. after ____ hrs. pumping ____ g.p.m. ____ ft. after ____ hrs. pumping ____ g.p.m. Estimated maximum yield 60 g.p.m.	
Clay		2	290	13. Water sample submitted: ____ Yes <input checked="" type="checkbox"/> No Date ____	
Clay 30%, medium to large sand & gravel		290	360	14. Well head completion: <input type="checkbox"/> Pitless adapter 28 inches above grade	
				15. Well grouted? yes With: <input checked="" type="checkbox"/> Neat cement <input type="checkbox"/> Bentonite <input type="checkbox"/> Concrete Depth: From 0 ft. to 10 ft.	
				16. Nearest source of possible contamination: ft. 100 Direction NE Type oilwell Well disinfected upon completion? <input checked="" type="checkbox"/> Yes <input type="checkbox"/> No	
				17. Pump: <input checked="" type="checkbox"/> Not installed Manufacturer's name _____ Model number _____ HP _____ Volts _____ Length of drop pipe _____ ft. capacity _____ g.p.m. Type: <input type="checkbox"/> Submersible <input type="checkbox"/> Turbine <input type="checkbox"/> Jet <input type="checkbox"/> Reciprocating <input type="checkbox"/> Centrifugal <input type="checkbox"/> Other	
		(Use a second sheet if needed)			
18. Elevation: Topography: <input type="checkbox"/> Hill <input type="checkbox"/> Slope <input checked="" type="checkbox"/> Upland <input type="checkbox"/> Valley		19. Remarks:		20. Water well contractor's certification: This well was drilled under my jurisdiction and this report is true to the best of my knowledge and belief. Carlile Water Well Ser. 118 Business name Box 275, Liberal, KS License No. _____ Address _____ Signed Edward E. Means Date 3-31-78 Authorized representative	

Forward the white, blue and pink copies to the Department of Health and Environment

Form WWC-5