

USE TYPEWRITER OR BALL
POINT PEN-PRESS FIRMLY,
PRINT CLEARLY.

WATER WELL RECORD
KSA 82a-1201-1215

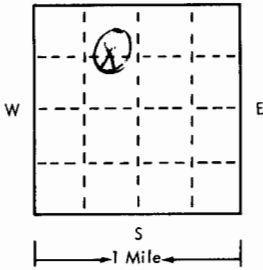
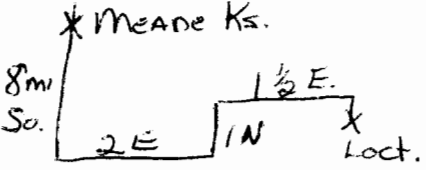
T R EW sec 1/4 1/4 1/4 No.

Kansas State Dept. Of Health
(Water Well Contractors)
Forbes-Bldg. 740
Topeka, Kansas 66620

Isaac #1

CWW Inv # 10988

BDA

1 Location of well:	County Meade	Township name	Fraction C-E$\frac{1}{2}$-NW	Section number 17	Town number 33	Range number 27	
Distance and direction from nearest town or city: 3$\frac{1}{2}$ miles East of Meade Lake			3 Owner of well: Leban Drilling Co.				
Street address of well location if in city:			Address: Suite 400, 111 W. Douglas Wichita, Kansas 67202				
Locate with "X" in section below: 			Sketch map: 			4 Well depth: 220 ft. Date of completion 1-21-75 Well diameter 9 in.	
2 Type and color of material			From		To		5 <input type="checkbox"/> Cable tool <input checked="" type="checkbox"/> Rotary <input type="checkbox"/> Driven <input type="checkbox"/> Dug <input type="checkbox"/> Hollow rod <input type="checkbox"/> Jetted <input type="checkbox"/> Bored <input type="checkbox"/> Reverse rotary
							6 Use: <input type="checkbox"/> Domestic <input type="checkbox"/> Public supply <input checked="" type="checkbox"/> Industry <input type="checkbox"/> Irrigation <input type="checkbox"/> Air conditioning <input type="checkbox"/> Commercial <input type="checkbox"/> Test well <input type="checkbox"/> Oil Well
Surface			0		3		7 Casing: Material PVC Height: above/below Threaded <input type="checkbox"/> Welded <input type="checkbox"/> Surface 12 in. Digm. 5$\frac{1}{2}$ in. to 190 ft. depth Drive shoe? <input type="checkbox"/> Yes <input checked="" type="checkbox"/> No 5$\frac{1}{2}$ in. to 220 ft. depth
Brown Clay			3		14		8 Screen: Manufacturer Wesco Type PVC Dia. 5$\frac{1}{2}$ Slot/gauze .030 Length 10 Set between 190 ft. and 200 ft. Fittings: 1/8 to 3/16 Gravel pack <input checked="" type="checkbox"/> Yes <input type="checkbox"/> No Size range of material
Red Clay w/sand & gravel streaks			14		76		9 Static water level: 99 ft. below land surface Date 1-21-75
Brown Clay			76		118		10 Pumping level below land surfaces: ____ ft. after ____ hrs. pumping ____ g.p.m. ____ ft. after ____ hrs. pumping ____ g.p.m. Estimated maximum yield 55 g.p.m.
Brown Clay w/sand			118		137		11 Water sample submitted: <input type="checkbox"/> Yes <input checked="" type="checkbox"/> No Date
Sand & Gravel			137		210		12 Well head completion: <input type="checkbox"/> Pitless adapter <input checked="" type="checkbox"/> 12 inches above grade
Red Bed			210		220		13 Well grouted? <input checked="" type="checkbox"/> Yes <input type="checkbox"/> No <input checked="" type="checkbox"/> Neat cement <input checked="" type="checkbox"/> Bentonite <input type="checkbox"/> Depth: From 0 ft. to 10 ft.
Well Given to Harvey Isaac Englewood Route Meade, Kansas							14 Nearest source of possible contamination: ft. 100 Direction SW Type Oil Well Well disinfected upon completion? <input checked="" type="checkbox"/> Yes <input type="checkbox"/> No
							15 Pump: <input checked="" type="checkbox"/> Not installed Manufacturer's name Model number ____ HP ____ Volts ____ Length of drop pipe ____ ft. capacity ____ g.m.p. Type: <input type="checkbox"/> Submersible <input type="checkbox"/> Turbine <input type="checkbox"/> Jet <input type="checkbox"/> Reciprocating <input type="checkbox"/> Centrifugal <input type="checkbox"/> Other
(use a second sheet if needed)							17 Water well contractor's certification: This well was drilled under my jurisdiction and this report is true to the best of my knowledge and belief. Carlile Water Well 118 Business name License No. Address Box 275, Liberal, Ks. Signed Edward E. Means Date 1-24-75 Authorized representative
16 Remarks: elevation Topography: <input type="checkbox"/> Hill <input type="checkbox"/> Slope <input checked="" type="checkbox"/> Upland <input type="checkbox"/> Valley							

Forward the white, blue and pink copies to the Kansas State Dept. Of Health.

Form WWC-5