


1 LOCATION OF WATER WELL:		Fraction		Section Number		Township Number		Range Number	
County:	Meade	SW 1/4	SW 1/4	SE 1/4	12	T 33 S	R 28	E-W	

Distance and direction from nearest town or city street address of well if located within city?

6 1/2 South, 1 1/2 East of Meade, Kansas

2] WATER WELL OWNER:	Mike Friesen	
RR#, St. Address, Box # :	HCR-3, Box 24	Board of Agriculture, Division of Water Resources
City, State, ZIP Code :	Meade, KS 67864	Application Number: ---

3 LOCATE WELL'S LOCATION WITH AN "X" IN SECTION BOX: 4 DEPTH OF COMPLETED WELL: 160 ft. ELEVATION: Slope

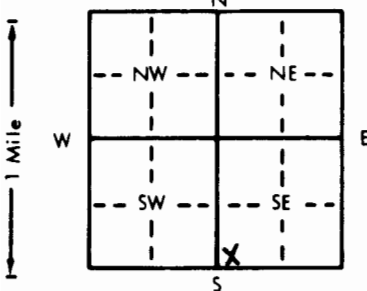

Depth(s) Groundwater Encountered 1. **Not available** ft. 2. _____ ft. 3. _____ ft.

WELL'S STATIC WATER LEVEL **120** ft. below land surface measured on mo/day/yr **Nov. 14, 1989**

Pump test data: Well water was ft. after hours pumping gpm

Est. Yield **20** ... gpm: Well water was ft. after hours pumping gpm

Bore Hole Diameter. **10** in. to **160** ft., and in. to ft.

WELL WATER TO BE USED AS:

	5 Public water supply	8 Air conditioning	11 Injection well
XX Domestic	3 Feedlot	6 Oil field water supply	9 Dewatering
2 Irrigation	4 Industrial	7 Lawn and garden only	10 Monitoring well
			12 Other (Specify below)

Was a chemical/bacteriological sample submitted to Department? Yes.....No...**XX**...; If yes, mo/day/yr sample was submitted

Water Well Disinfected? Yes **XX** No

5	TYPE OF BLANK CASING USED:		5 Wrought iron	8 Concrete tile	CASING JOINTS: Glued <u>XX</u> . Clamped Welded Threaded
	1 Steel	3 RMP (SR)	6 Asbestos-Cement	9 Other (specify below)	
	<u>XX</u> PVC	4 ABS	7 Fiberglass		

Blank casing diameter 5 . . . in. to . . . 120 . . . ft., Dia in. to ft., Dia in. to ft.
Casing height above land surface . . . 20 . . . in., weight . . . 2.8 . . . lbs./ft. Wall thickness or gauge No. . . 265

TYPE OF SCREEN OR PERFORATION MATERIAL:			XX PVC	10 Asbestos-cement
1 Steel	3 Stainless steel	5 Fiberglass	8 RMP (SR)	11 Other (specify)
2 Brass	4 Galvanized steel	6 Concrete tile	9 ABS	12 None used (open hole)

SCREEN OR PERFORATION OPENINGS ARE:

1 Continuous slot	3 Mill slot	5 Gauzed wrapped	X 8 Saw cut	11 None (open hole)
2 Louvered shutter	4 Key punched	6 Wire wrapped	9 Drilled holes	
		7 Torch cut	10 Other (specify)	

SCREEN-PERFORATED INTERVALS: From . . . 120 ft. to . . . 160 ft., From ft. to ft.
From ft. to ft., From ft. to ft.
GRAVEL PACK INTERVALS: From . . . 20 ft. to . . . 160 ft., From ft. to ft.
From ft. to ft., From ft. to ft.

6 GROUT MATERIAL: 1 Neat cement 2 Cement grout 3 Bentonite ~~XXX~~ Other Baroid Hole Plug
Grout Intervals: From 0 ft. to 20 ft., From _____ ft. to _____ ft., From _____ ft. to _____ ft.

What is the nearest source of possible contamination:

<input checked="" type="checkbox"/> Septic tank	4 Lateral lines	7 Pit privy	10 Livestock pens	14 Abandoned water well
2 Sewer lines	5 Cess pool	8 Sewage lagoon	11 Fuel storage	15 Oil well/Gas well
3 Watertight sewer lines	6 Seepage pit	9 Feedyard	12 Fertilizer storage	16 Other (specify below)
			13 Insecticide storage

Direction from well?	West	How many feet?	100
----------------------	------	----------------	-----

[illegible]

7 CONTRACTOR'S OR LANDOWNER'S CERTIFICATION: This water well was (1) constructed, (2) reconstructed, or (3) plugged under my jurisdiction and was completed on (mo/day/year) Nov. 14, 1989 and this record is true to the best of my knowledge and belief. Kansas Water Well Contractor's License No. 252 This Water Well Record was completed on (mo/day/year) Nov. 20, 1989 under the business name of FRIESEN WINDMILL & SUPPLY INC. by (signature) [Signature]

7-8902038024