

USE TYPEWRITER OR BALL
POINT PEN-PRESS FIRMLY,
PRINT CLEARLY.

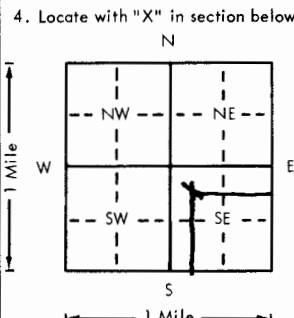
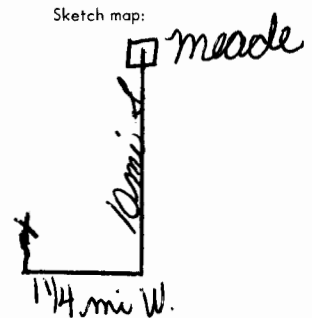
WATER WELL RECORD
KSA 82a-1201-1215

Kansas Department of Health and
Environment-Division of Environment
(Water well Contractors)
Topeka, Kansas 66620

Permit no 79-291

CWW16569

Hension #1-28

1. Location of well:		County Meade	Fraction 1/4 C-NW SE	Section number 28	Township number T 33 S R 28 E/W	Range number 28
2. Distance and direction from nearest town or city: From Meade go 10 mi south 1 1/4 mi west then north into location			3. Owner of well: Sage Drilling R.R. or street 222 Sutton Place City, state, zip code: Wichita, Kansas 67901			
4. Locate with "X" in section below:		Sketch map:		6. Bore hole dia. 9 in. Completion date 12-17-79 Well depth 240 ft.		
				7. <input type="checkbox"/> Cable tool <input checked="" type="checkbox"/> Rotary <input type="checkbox"/> Driven <input type="checkbox"/> Dug <input type="checkbox"/> Hollow rod <input type="checkbox"/> Jetted <input type="checkbox"/> Bored <input type="checkbox"/> Reverse rotary		
5. Type and color of material		From	To	8. Use: <input type="checkbox"/> Domestic <input type="checkbox"/> Public supply <input type="checkbox"/> Industry <input type="checkbox"/> Irrigation <input type="checkbox"/> Air conditioning <input type="checkbox"/> Stock <input type="checkbox"/> Lawn <input checked="" type="checkbox"/> Oil field water <input type="checkbox"/> Other		
Surface		0	2	9. Casing: Material <input type="checkbox"/> Height: Above or below Threaded <input type="checkbox"/> Welded <input type="checkbox"/> Surface 28 in. RMP <input type="checkbox"/> PVC <input checked="" type="checkbox"/> Weight 2.78 lbs./ft. Dia. 5 in. to 120 depth Wall Thickness: inches or Dia. <input type="checkbox"/> in. to <input type="checkbox"/> ft. depth gage No. .256		
Medium to large sand		2	13	10. Screen: Manufacturer's name <input type="checkbox"/> Type Sawed Dia. 5" Slot/gauze .030 Length 120' Set between 100 ft. and 220 ft. Gravel pack? Yes Size range of material 1/8-3/16		
70% clay & 30% fine sand		13	85	11. Static water level: <input type="checkbox"/> mo./day/yr. 170 ft. below land surface Date 12-17-79		
Medium to large sand		85	103	12. Pumping level below land surfaces: <input type="checkbox"/> ft. after <input type="checkbox"/> hrs. pumping <input type="checkbox"/> g.p.m. <input type="checkbox"/> ft. after <input type="checkbox"/> hrs. pumping <input type="checkbox"/> g.p.m. Estimated maximum yield 40 g.p.m.		
Fine sand		103	118	13. Water sample submitted: <input type="checkbox"/> mo./day/yr. <input type="checkbox"/> Yes <input checked="" type="checkbox"/> No Date <input type="checkbox"/>		
Medium to large sand		118	163	14. Well head completion: <input checked="" type="checkbox"/> Pitless adapter 28 inches above grade		
20% fine sand & 80% red clay		163	240	15. Well grouted? Yes With: <input checked="" type="checkbox"/> Neat cement <input type="checkbox"/> Bentonite <input type="checkbox"/> Concrete Depth: From 0 ft. to 10 ft.		
				16. Nearest source of possible contamination: ft. 100 Direction N.E. Type Oil well Well disinfected upon completion? <input checked="" type="checkbox"/> Yes <input type="checkbox"/> No		
				17. Pump: <input checked="" type="checkbox"/> Not installed Manufacturer's name <input type="checkbox"/> Model number <input type="checkbox"/> HP <input type="checkbox"/> Volts <input type="checkbox"/> Length of drop pipe <input type="checkbox"/> ft. capacity <input type="checkbox"/> g.p.m. Type: <input type="checkbox"/> Submersible <input type="checkbox"/> Turbine <input type="checkbox"/> Jet <input type="checkbox"/> Reciprocating <input type="checkbox"/> Centrifugal <input type="checkbox"/> Other		
				20. Water well contractor's certification: This well was drilled under my jurisdiction and this report is true to the best of my knowledge and belief. 118 Carlile Water Well Service Business name <input type="checkbox"/> License No. <input type="checkbox"/> Address Box AA Liberal, Kansas Signed Edward E. Manso Date 12-27-79 Authorized representative		
18. Elevation: 2460 Topography: <input type="checkbox"/> Hill <input type="checkbox"/> Slope <input checked="" type="checkbox"/> Upland <input type="checkbox"/> Valley		19. Remarks: 2460 22				

Forward the white, blue and pink copies to the Department of Health and Environment

Form WWC-5