


1 LOCATION OF WATER WELL:	Fraction	Section Number	Township Number	Range Number
County: Meade	NE 1/4 NW 1/4 SE 1/4	14	T 33 S	R 29 E (W)

Distance and direction from nearest town or city street address of well if located within city?

Meade, ks 12.2 S & W on Highway 23 1.2 west on ST rd 115' N

2 WATER WELL OWNER:	Board of Agriculture, Division of Water Resources
RR#, St. Address, Box # :	Application Number:
City, State, ZIP Code :	

3 LOCATE WELL'S LOCATION WITH AN "X" IN SECTION BOX:	4 DEPTH OF COMPLETED WELL: 42 ft. ELEVATION:
--	--

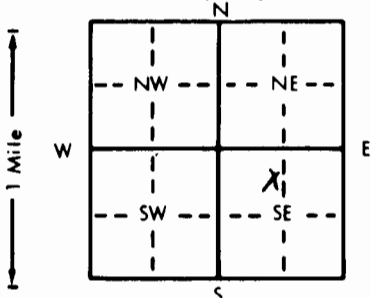

Depth(s) Groundwater Encountered 1. 30 ft. 2. ft. 3. ft.	WELL'S STATIC WATER LEVEL 30 ft. below land surface measured on mo/day/yr 2-1-96
Pump test data: Well water was ft. after hours pumping gpm	Est. Yield gpm: Well water was ft. after hours pumping gpm
Bore Hole Diameter in. to ft., and in. to ft.	WELL WATER TO BE USED AS:
1 Domestic 3 Feedlot 6 Oil field water supply 9 Dewatering 12 Other (Specify below)	2 Irrigation 4 Industrial 7 Lawn and garden only 10 Monitoring well
Was a chemical/bacteriological sample submitted to Department? Yes No If yes, mo/day/yr sample was submitted	Water Well Disinfected? Yes No

5 TYPE OF BLANK CASING USED:	5 Wrought iron	8 Concrete tile	CASING JOINTS: Glued Clamped
1 Steel	3 RMP (SR)	6 Asbestos-Cement	9 Other (specify below)
2 PVC	4 ABS	7 Fiberglass	10 Asbestos-cement
Blank casing diameter in. to ft., Dia in. to ft., Dia in. to ft.	Casing height above land surface 3' below in., weight lbs./ft. Wall thickness or gauge No.	TYPE OF SCREEN OR PERFORATION MATERIAL:	11 Other (specify) NA
1 Steel	3 Stainless steel	5 Fiberglass	8 RMP (SR)
2 Brass	4 Galvanized steel	6 Concrete tile	9 ABS
SCREEN OR PERFORATION OPENINGS ARE:	5 Gauzed wrapped	8 Saw cut	11 None (open hole)
1 Continuous slot	3 Mill slot	6 Wire wrapped	9 Drilled holes
2 Louvered shutter	4 Key punched	7 Torch cut	10 Other (specify) NA
SCREEN-PERFORATED INTERVALS: From 999 ft. to 999 ft.	From ft. to ft.	From ft. to ft.	From ft. to ft.
GRAVEL PACK INTERVALS: From ft. to ft.	From ft. to ft.	From ft. to ft.	From ft. to ft.

6 GROUT MATERIAL:	1 Neat cement	2 Cement grout	3 Bentonite	4 Other
Grout Intervals: From 6 ft. to 3 ft.	From ft. to ft.	From ft. to ft.	From ft. to ft.	From ft. to ft.
What is the nearest source of possible contamination:	1 Septic tank	4 Lateral lines	7 Pit privy	10 Livestock pens
2 Sewer lines	5 Cess pool	8 Sewage lagoon	11 Fuel storage	14 Abandoned water well
3 Watertight sewer lines	6 Seepage pit	9 Feedyard	12 Fertilizer storage	15 Oil well/Gas well
Direction from well? West	How many feet? 2			

FROM	TO	LITHOLOGIC LOG	FROM	TO	PLUGGING INTERVALS
42	30		42	30	Drillate/sand 2.4 cubic ft
30	6		30	6	Clay & subsoil 4.8 cubic ft
6	3		6	3	Cement grout .60 cubic ft
3	0		3	0	Subsoil & clay

7 CONTRACTOR'S OR LANDOWNER'S CERTIFICATION: This water well was (1) constructed, (2) reconstructed, or (3) plugged under my jurisdiction and was completed on (mo/day/year) 2-7-96 and this record is true to the best of my knowledge and belief. Kansas Water Well Contractor's License No. 598 This Water Well Record was completed on (mo/day/yr) 2-8-96 under the business name of Jim's Water Well Drilling by (signature) James S. Newman

INSTRUCTIONS: Use typewriter or ball point pen. PLEASE PRESS FIRMLY and PRINT clearly. Please fill in blanks, underline or circle the correct answers. Send top three copies to Kansas Department of Health and Environment, Bureau of Water, Topeka, Kansas 66620-0001. Telephone: 913-296-5545. Send one to WATER WELL OWNER and retain one for your records.