


1 LOCATION OF WATER WELL:		Fraction	Section Number	Township Number	Range Number
County: Meade		NE ¼ SE ¼ SW ¼	4	T 33 S	R 29 W

Distance and direction from nearest town or city street address of well if located within city?

5 East and 3 1/2 South of Plains, Kansas

2	WATER WELL OWNER:	Keystone Grazing c/o Bill Preedy	
	RR#, St. Address, Box # :	Rt. 1	Board of Agriculture, Division of Water Resources
	City, State, ZIP Code :	Satanta, KS 67870	Application Number: _____

3 LOCATE WELL'S LOCATION WITH AN "X" IN SECTION BOX: 4 DEPTH OF COMPLETED WELL.....160.....ft. ELEVATION: .....Hill.....

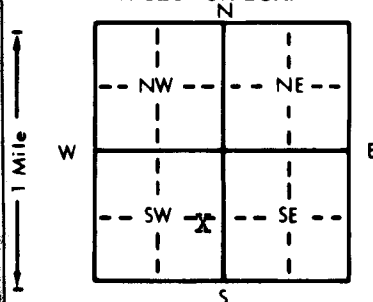

4 DEPTH OF COMPLETED WELL. 160 ft. ELEVATION: Hill  
Depth(s) Groundwater Encountered 1. Not available 2. ft. 3. ft.  
WELL'S STATIC WATER LEVEL 81 ft. below land surface measured on mo/day/yr June 13, 1988  
Pump test data: Well water was ft. after hours pumping gpm  
Est. Yield 20 gpm: Well water was ft. after hours pumping gpm  
Bore Hole Diameter 10 in. to 160 ft., and in. to ft.  
WELL WATER TO BE USED AS: 5 Public water supply 8 Air conditioning 11 Injection well  
XX Domestic 3 Feedlot 6 Oil field water supply 9 Dewatering 12 Other (Specify below)  
2 Irrigation 4 Industrial 7 Lawn and garden only 10 Observation well  
Was a chemical/bacteriological sample submitted to Department? Yes No XX; If yes, mo/day/yr sample was submitted  
Water Well Disinfected? Yes XX No

5 TYPE OF BLANK CASING USED:		5 Wrought iron	8 Concrete tile	CASING JOINTS: Glued <u>XX</u> . . . Clamped . . . . .
1 Steel	3 RMP (SR)	6 Asbestos-Cement	9 Other (specify below)	Welded . . . . .
<u>XX</u> PVC	4 ABS	7 Fiberglass		Threaded. . . . .
Blank casing diameter . . . <u>5</u> . . . . in. to <u>140</u> . . . . ft., Dia		. . . in. to . . . . ft., Dia . . . in. to . . . . ft.		
Casing height above land surface . . . <u>24</u> . . . in., weight . . . <u>2.8</u> . . . lbs./ft.		Wall thickness or gauge No. . . . <u>265</u>		

TYPE OF SCREEN OR PERFORATION MATERIAL:			<input checked="" type="checkbox"/> PVC	10 Asbestos-cement
1 Steel	3 Stainless steel	5 Fiberglass	8 RMP (SR)	11 Other (specify) .....
2 Brass	4 Galvanized steel	6 Concrete tile	9 ABS	12 None used (open hole)

SCREEN OR PERFORATION OPENINGS ARE:		5 Gauzed wrapped	<input checked="" type="checkbox"/> Saw cut	11 None (open hole)
1 Continuous slot	3 Mill slot	6 Wire wrapped	9 Drilled holes	
2 Louvered shutter	4 Key punched	7 Torch cut	10 Other (specify) .....	

SCREEN-PERFORATED INTERVALS:	From . . . 140 . . . . . ft. to . . . 160 . . . . . ft.,	From . . . . . ft. to . . . . . ft.
	From . . . . . ft. to . . . . . ft.,	From . . . . . ft. to . . . . . ft.
GRAVEL PACK INTERVALS:	From . . . 0 . . . . . ft. to . . . 70 . . . . . ft.,	From . . . . . ft. to . . . . . ft.
	From 90 . . . . . ft. to 160 . . . . . ft.,	From . . . . . ft. to . . . . . ft.

6	GROUT MATERIAL:	1 Neat cement	2 Cement grout	3 Bentonite	<input checked="" type="checkbox"/> Other	Baroid Hole Plug
	Grout Intervals:	From 70 ft. to 90	ft. From	ft. to	ft. From	ft. to

What is the nearest source of possible contamination: **NONE**

1 Septic tank	4 Lateral lines	7 Pit privy	10 Livestock pens	14 Abandoned water well
2 Sewer lines	5 Cess pool	8 Sewage lagoon	11 Fuel storage	15 Oil well/Gas well
3 Watertight sewer lines	6 Seepage pit	9 Feedyard	12 Fertilizer storage	16 Other (specify below)
			13 Insecticide storage	

Direction from well? \_\_\_\_\_ How many feet? \_\_\_\_\_

[illegible]

7 CONTRACTOR'S OR LANDOWNER'S CERTIFICATION: This water well was (1) constructed, (2) reconstructed, or (3) plugged under my jurisdiction and was completed on (mo/day/year) June 14, 1988 and this record is true to the best of my knowledge and belief. Kansas Water Well Contractor's License No. 252 This Water Well Record was completed on (mo/day/year) June 20, 1988 under the business name of Friesen Windmill & Supply Inc. by (signature) [Signature]

INSTRUCTIONS: Use typewriter or ball point pen. PLEASE PRESS FIRMLY and PRINT clearly. Please fill in blanks, underline or circle the correct answers. Send top three copies to Kansas Department of Health and Environment, Bureau of Water Protection, Topeka, Kansas 66620-7320, Telephone: 913-862-9360. Send one to WATER WELL OWNER and retain one for your records.

10-8/00000245