

USE TYPEWRITER OR BALL
POINT PEN-PRESS FIRMLY,
PRINT CLEARLY.

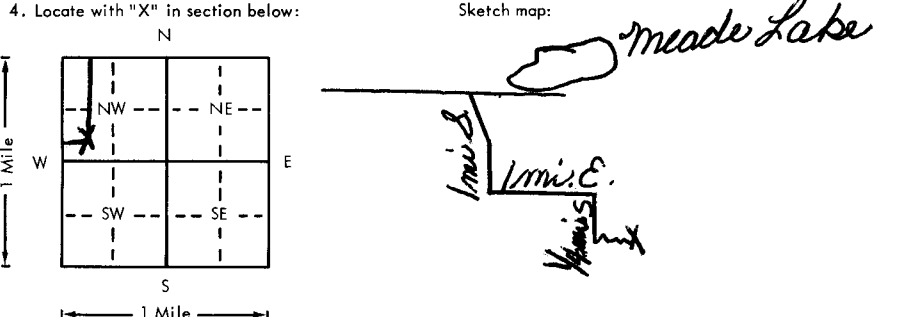
WATER WELL RECORD
KSA 82a-1201-1215

Kansas Department of Health and
Environment-Division of Environment
(Water well Contractors)
Topeka, Kansas 66620

Permit no 79-262

CWW 16498

Barragee #2-25

1. Location of well:	County Meade	Fraction $\frac{1}{4}$ C-SW $\frac{1}{4}$ NW $\frac{1}{4}$	Section number 25	Township number T 33 S	Range number R 29 E/W
2. Distance and direction from nearest town or city: From Meade Lake go 1mi South 1mi East 1mi south east into location			3. Owner of well: Sage Drilling R.R. or street: 222 Sutton Place City, state, zip code: Wichita, Kansas 67202		
4. Locate with "X" in section below: 			6. Bore hole dia. 9 in. Completion date 11-26-79 Well depth 240 ft.		
5. Type and color of material			7. <input type="checkbox"/> Cable tool <input checked="" type="checkbox"/> Rotary <input type="checkbox"/> Driven <input type="checkbox"/> Dug <input type="checkbox"/> Hollow rod <input type="checkbox"/> Jetted <input type="checkbox"/> Bored <input type="checkbox"/> Reverse rotary		
			8. Use: <input type="checkbox"/> Domestic <input type="checkbox"/> Public supply <input type="checkbox"/> Industry <input type="checkbox"/> Irrigation <input type="checkbox"/> Air conditioning <input type="checkbox"/> Stock <input type="checkbox"/> Lawn <input checked="" type="checkbox"/> Oil field water <input type="checkbox"/> Other		
			9. Casing: Material <input type="checkbox"/> Height: Above or below Threaded <input type="checkbox"/> Welded <input type="checkbox"/> Surface 28 in. RMP <input type="checkbox"/> PVC <input checked="" type="checkbox"/> Weight 2.78 lbs./ft. Dia. 5 in. to 160 ft. depth Wall Thickness: inches or Dia. <input type="checkbox"/> in. to <input type="checkbox"/> ft. depth gage No. 256		
			10. Screen: Manufacturer's name <input type="checkbox"/> Type Sawed PVC Dia. 5" Slot/gauze .030 Length 80' Set between 160 ft. and 240 ft. Gravel pack? Yes Size range of material 1/8-3/16		
			11. Static water level: 218 ft. below land surface Date 11-26-79 mo./day/yr.		
			12. Pumping level below land surfaces: ____ ft. after ____ hrs. pumping ____ g.p.m. ____ ft. after ____ hrs. pumping ____ g.p.m. Estimated maximum yield 15 g.p.m.		
			13. Water sample submitted: ____ mo./day/yr. <input type="checkbox"/> Yes <input checked="" type="checkbox"/> No Date ____		
			14. Well head completion: <input checked="" type="checkbox"/> Pitless adapter 28 Inches above grade		
			15. Well grouted? Yes With: <input checked="" type="checkbox"/> Neat cement <input type="checkbox"/> Bentonite <input type="checkbox"/> Concrete Depth: From 0 ft. to 10 ft.		
			16. Nearest source of possible contamination: 100 ft. Direction N.E. Type Oil well Well disinfected upon completion? <input checked="" type="checkbox"/> Yes <input type="checkbox"/> No		
			17. Pump: <input checked="" type="checkbox"/> Not installed Manufacturer's name ____ Model number ____ HP ____ Volts ____ Length of drop pipe ____ ft. capacity ____ g.p.m. Type: <input type="checkbox"/> Submersible <input type="checkbox"/> Turbine <input type="checkbox"/> Jet <input type="checkbox"/> Reciprocating <input type="checkbox"/> Centrifugal <input type="checkbox"/> Other		
(Use a second sheet if needed)					
18. Elevation:	19. Remarks:		20. Water well contractor's certification: This well was drilled under my jurisdiction and this report is true to the best of my knowledge and belief. 118 Carlile Water Well Service Business name Box AA Liberal, Kansas License No. ____ Address Edward E. Means Date 12-5-79 Signed Edward E. Means Authorized representative		

Forward the white, blue and pink copies to the Department of Health and Environment

Form WWC-5