

County: Meade Fraction SE-NW-NE Sec. 10 T 33 S R 29 E(W)

CORRECTION(S) TO WATER WELL COMPLETION RECORD (WWC-5)
(to rectify lacking or incorrect information)

Owner: Edison Operating Com

Location was listed as:

Section-Township-Range: 10-33S-29E

Fraction (1/4 1/4 1/4): None

Location changed to:

10-33S-29E

SE-NW-NE

Other changes: Initial statements: _____

Changed to: _____

Comments: _____

Verification method: Location marked on map of WWC5 Form

initials: DF date: 4/15/14


Submitted by: Kansas Geological Survey, Data Resources Library, 1930 Constant Ave., Lawrence, KS 66047-3726
to: Kansas Dept of Health & Environment, Bureau of Water, 1000 SW Jackson, Suite 420, Topeka, KS 66612-1367.

WATER WELL RECORD

Form WWC-5

Division of Water Resources App. No.

1 LOCATION OF WATER WELL: County: MEADE COUNTY, KS Fraction 1/4 1/4 1/4 1/4 Section Number 10 Township No. T 33 S Range Number R 29 E W
Street/Rural Address of Well Location; if unknown, distance & direction from nearest town or intersection: If at owner's address, check here [] sw meade Lake 23 w on v rd 6/10 fork in rd 1/2 m to wildlife area sign n/nw 1.7m 200'w
2 WATER WELL OWNER: EDISON OPERATING COM RR#, Street Address, Box #: 8100 E 22ND ST N City, State, ZIP Code : WICHITA KS 67226
Global Positioning System (GPS) information: Latitude: Longitude: Elevation: Datum: [] WGS 84, [] NAD 83, [] NAD 27 Collection Method: [] GPS unit (Make/Model: [] Digital Map/Photo, [] Topographic Map, [] Land Survey Est. Accuracy: [] <3 m, [] 3-5 m, [] 5-15 m, [] >15 m

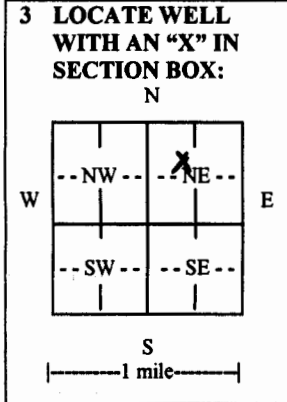

4 DEPTH OF COMPLETED WELL 300 ft. Depth(s) Groundwater Encountered (1).116 ft. (2) ft. (3) ft. WELL'S STATIC WATER LEVEL 116 ft. below land surface measured on mo/day/yr. 1-15-14 Pump test data: Well water was 126 ft. after hours pumping 90 gpm EST. YIELD 90 gpm. Well water was ft. after hours pumping gpm Bore Hole Diameter 10.75 in. to 300 ft., and in. to ft. WELL WATER TO BE USED AS: [] Public water supply [] Geothermal [] Injection well [] Domestic [] Feedlot [] Oil field water supply [] Dewatering [] Other (Specify below) [] Irrigation [] Industrial [] Domestic-lawn & garden [] Monitoring well Was a chemical/bacteriological sample submitted to Department? [] Yes [] No If yes, mo/day/yr sample was submitted. Water well disinfected? [] Yes [] No

5 TYPE OF CASING USED: [] Steel [] PVC [] Other CASING JOINTS: [] Glued [] Clamped [] Welded [] Threaded Casing diameter 6 in. to 300 ft., Diameter in. to ft., Diameter in. to ft. Casing height above land surface 24 in., Weight 3.706 lbs./ft., Wall thickness or gauge No. SDR 21-316 TYPE OF SCREEN OR PERFORATION MATERIAL: [] Steel [] Stainless Steel [] PVC [] Other (Specify) [] Brass [] Galvanized Steel [] None used (open hole) SCREEN OR PERFORATION OPENINGS ARE: [] Continuous slot [] Mill slot [] Gauze wrapped [] Torch cut [] Drilled holes [] None (open hole) [] Louvered shutter [] Key punched [] Wire wrapped [] Saw cut [] Other (specify) SCREEN-PERFORATED INTERVALS: From 200 ft. to 300 ft., From ft. to ft. GRAVEL PACK INTERVALS: From 170 ft. to 300 ft., From ft. to ft. From ft. to ft., From ft. to ft.

6 GROUT MATERIAL: [] Neat cement [] Cement grout [] Bentonite [] Other Grout Intervals: From 1 ft. to 25 ft., From ft. to ft., From ft. to ft. What is the nearest source of possible contamination: [] Septic tank [] Lateral lines [] Pit privy [] Livestock pens [] Insecticide storage [] Other (specify below) [] Sewer lines [] Cesspool [] Sewage lagoon [] Fuel storage [] Abandoned water well [] Watertight sewer lines [] Seepage pit [] Feedyard [] Fertilizer storage [] Oil well/gas well Direction from well Distance from well

Table with columns: FROM, TO, LITHOLOGIC LOG, FROM, TO, LITHO. LOG (cont.) or PLUGGING INTERVALS. Rows: 0-2 SURFACE, 2-35 CLAY, 35-134 SAND & "GRAVEL", 134-139 CLAY "BLUE", 139-194 SAND, 194-205 SAND & CLAY STREAKS, 205-290 SAND, 290-300 SAND & CLAY STREAKS

7 CONTRACTOR'S OR LANDOWNER'S CERTIFICATION: This water well was [] constructed, [] reconstructed, or [] plugged under my jurisdiction and was completed on (mo/day/year) 1-15-14 and this record is true to the best of my knowledge and belief. Kansas Water Well Contractor's License No. 1-15-14 This Water Well Record was completed on (mo/day/year) 1-15-14 under the business name of Howard Ding Co Box 806 Beaver Ok 73932 by (signature)

INSTRUCTIONS: Use typewriter or ball point pen. PLEASE PRESS FIRMLY and PRINT clearly. Please fill in blanks and check the correct answers. Send one copy to Kansas Department of Health and Environment, Bureau of Water, Geology Section, 1000 SW Jackson St., Suite 420, Topeka, Kansas 66612-1367. Telephone 785-296-5524. Send one copy to WATER WELL OWNER and retain one for your records. Include fee of \$5.00 for each constructed well. Visit us at http://www.kdheks.gov/waterwell/index.html