CWW 18942

WATER WELL RECORD Form WWC-5 KSA 82a-1212

Armen-Trout B #2

LOCATION OF WATER WELL: County: Meade	Fraction: ~~¼~~C-NW ¼ NW ¼	Section Number: 15	Township Number: T 33 S	Range Number: R 30 E/W

Distance and direction from nearest town or city street address of well if located within city? Go East on Meade Lake Road to caution light then 3/4mi North East into location.

WATER WELL OWNER: Cities Service

RR#, St. Address, Box # : 3545 N.W. 58th

City, State, ZIP Code : Oklahoma City, Oklahoma 73112

Board of Agriculture, Division of Water Resources Application Number: PT-81-653

LOCATE WELL'S LOCATION WITH AN "X" IN SECTION BOX:

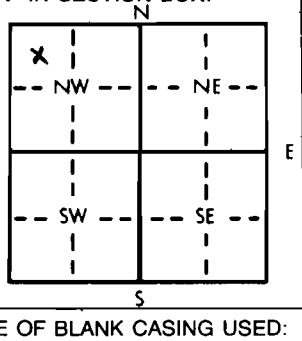

4 DEPTH OF COMPLETED WELL 360 ft. ELEVATION:

Depth(s) Groundwater Encountered 1. 170 ft. 2. ft. 3. ft.

WELL'S STATIC WATER LEVEL 190 ft. below land surface measured on mo/day/yr 10/1/81

Pump test data: Well water was ft. after hours pumping gpm

Est. Yield 50 gpm: Well water was ft. after hours pumping gpm

Bore Hole Diameter 9 in. to 360 ft., and in. to ft.

WELL WATER TO BE USED AS: 1 Domestic 2 Irrigation 3 Feedlot 4 Industrial 5 Public water supply 6 Oil field water supply 7 Lawn and garden only 8 Air conditioning 9 Dewatering 10 Observation well 11 Injection well 12 Other (Specify below)

Was a chemical/bacteriological sample submitted to Department? Yes ..... No ..... ; If yes, mo/day/yr sample was submitted

Water Well Disinfected? Yes No

TYPE OF BLANK CASING USED: 1 Steel 2 PVC 3 RMP (SR) 4 ABS 5 Wrought iron 6 Asbestos-Cement 7 Fiberglass 8 Concrete tile 9 Other (specify below)

CASING JOINTS: Glued Clamped Welded Threaded

Blank casing diameter 5 in. to 280 ft., Dia in. to ft., Dia in. to ft.

Casing height above land surface 28 in., weight 2.78 lbs./ft. Wall thickness or gauge No. .256

TYPE OF SCREEN OR PERFORATION MATERIAL: 1 Steel 2 Brass 3 Stainless steel 4 Galvanized steel 5 Fiberglass 6 Concrete tile 7 PVC 8 RMP (SR) 9 ABS 10 Asbestos-cement 11 Other (specify) 12 None used (open hole)

SCREEN OR PERFORATION OPENINGS ARE: 1 Continuous slot 2 Louvered shutter 3 Mill slot 4 Key punched 5 Gauzed wrapped 6 Wire wrapped 7 Torch cut 8 Saw cut 9 Drilled holes 10 Other (specify) 11 None (open hole)

SCREEN-PERFORATED INTERVALS: From 280 ft. to 360 ft., From ft. to ft.

From ft. to ft., From ft. to ft.

GRAVEL PACK INTERVALS: From 180 ft. to 360 ft., From ft. to ft.

From ft. to ft., From ft. to ft.

GROUT MATERIAL: 1 Neat cement 2 Cement grout 3 Bentonite 4 Other

Grout Intervals: From 0 ft. to 10 ft., From ft. to ft., From ft. to ft.

What is the nearest source of possible contamination: 1 Septic tank 2 Sewer lines 3 Watertight sewer lines 4 Lateral lines 5 Cess pool 6 Seepage pit 7 Pit privy 8 Sewage lagoon 9 Feedyard 10 Livestock pens 11 Fuel storage 12 Fertilizer storage 13 Insecticide storage 14 Abandoned water well 15 Oil well/Gas well 16 Other (specify below)

Direction from well? Northeast of water well. How many feet? 100

FROM	TO	LITHOLOGIC LOG	FROM	TO	LITHOLOGIC LOG
0	2	surface			
2	23	clay			
23	35	sandy clay			
35	42	caliche			
42	85	sandy clay			
85	205	fine sand			
205	275	blue clay			
275	360	fine sand			

CONTRACTOR'S OR LANDOWNER'S CERTIFICATION: This water well was (1) constructed, (2) reconstructed, or (3) plugged under my jurisdiction and was completed on (mo/day/year) October 1, 1981 and this record is true to the best of my knowledge and belief. Kansas Water Well Contractor's License No. 118 This Water Well Record was completed on (mo/day/yr) October 13, 1981 under the business name of Carlile Water Well Service, Inc. by (signature) Edward E. Means

INSTRUCTIONS: Use typewriter or ball point pen, *PLEASE PRESS FIRMLY* and *PRINT* clearly. Please fill in blanks, underline or circle the correct answers. Send top three copies to Kansas Department of Health and Environment, Division of Environment, Environmental Geology Section, Topeka, KS 66620. Send one to WATER WELL OWNER and retain one for your records.

OFFICE USE ONLY T 33 R 30 E/W SEC. 15 CW ¼ NW ¼ ¼