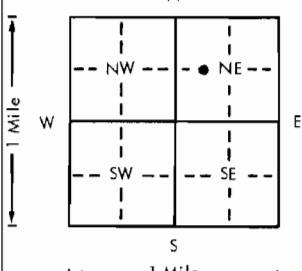


USE TYPEWRITER OR BALL
POINT PEN-PRESS FIRMLY,
PRINT CLEARLY.

WATER WELL RECORD
KSA 82a-1201-1215

Kansas Department of Health and
Environment-Division of Environment
(Water well Contractors)
Topeka, Kansas 66620

1. Location of well:		County Meade	Fraction Center of W 1/2 of 1/4 1/4 NE 1/4	Section number 18	Township number T 33 S R 30 E (W)	Range number
2. Distance and direction from nearest town or city: 6 miles South - 2 miles West - 3/4 miles North - 1/4 miles			3. Owner of well: SEARCH DRILLING CO. R.R. or street: Box 18148 City, state, zip code: Wichita, Kansas 67218			
4. Locate with "X" in section below: Sketch map: 			6. Bore hole dia. 4 in. Completion date 12/5/78 Well depth 360 ft.			
5. Type and color of material			7. <input checked="" type="checkbox"/> Cable tool <input checked="" type="checkbox"/> Rotary <input type="checkbox"/> Driven <input type="checkbox"/> Dug <input type="checkbox"/> Hollow rod <input type="checkbox"/> Jetted <input type="checkbox"/> Bored <input type="checkbox"/> Reverse rotary			
			8. Use: <input type="checkbox"/> Domestic <input type="checkbox"/> Public supply <input type="checkbox"/> Industry <input type="checkbox"/> Irrigation <input type="checkbox"/> Air conditioning <input type="checkbox"/> Stock <input type="checkbox"/> Lawn <input checked="" type="checkbox"/> Off field water <input type="checkbox"/> Other			
			9. Casing: Material PVC Height: Above or below Threaded <input type="checkbox"/> Welded glue Surface 20 in. RMP <input type="checkbox"/> PVC <input checked="" type="checkbox"/> Weight 200 lbs./ft. Dia. 5 in. to 280 ft. depth Wall Thickness: inches or Dia. <input type="checkbox"/> in. to <input type="checkbox"/> ft. depth Gauge No. 0.258			
			10. Screen: Manufacturer's name Peerless Plastic Type PVC Dia. 5" Slot/gauze 1/16 Length 80' Set between 280 ft. and 360 ft. ft. and ft. Gravel pack? yes Size range of material 1/8			
			11. Static water level: 200 ft. below land surface Date 12/5/78 mo./day/yr.			
(Use a second sheet if needed)			12. Pumping level below land surfaces: 240 ft. after 1 hrs. pumping 80 g.p.m. ft. after hrs. pumping g.p.m. Estimated maximum yield 120 g.p.m.			
			13. Water sample submitted: mo./day/yr. <input type="checkbox"/> Yes <input checked="" type="checkbox"/> No Date			
			14. Well head completion: <input type="checkbox"/> Pitless adapter 20 inches above grade			
			15. Well grouted? yes With: <input checked="" type="checkbox"/> Neat cement <input type="checkbox"/> Bentonite <input type="checkbox"/> Concrete Depth: From 0 ft. to 10 ft.			
			16. Nearest source of possible contamination: ft. Direction Type None Well disinfected upon completion? <input checked="" type="checkbox"/> Yes <input type="checkbox"/> No			
18. Elevation: Topography: <input type="checkbox"/> Hill <input checked="" type="checkbox"/> Slope <input checked="" type="checkbox"/> Upland <input type="checkbox"/> Valley			17. Pump: Not installed Manufacturer's name Valley Model number 75 HP 1/2 Volts 230 Length of drop pipe 300 ft. capacity 80 g.p.m. Type: <input checked="" type="checkbox"/> Submersible <input type="checkbox"/> Turbine <input type="checkbox"/> Jet <input type="checkbox"/> Reciprocating <input type="checkbox"/> Centrifugal <input type="checkbox"/> Other			
			20. Water well contractor's certification: This well was drilled under my jurisdiction and this report is true to the best of my knowledge and belief. TFW Water Well Service Inc 1/4/2 Business name License No. Address Box 8116 Liberal Kansas 67201 Signed (Signature) Date 12/4/78 Authorized representative			
			19. Remarks:			
			1/4 1/4 NE			
			CU NE			

Forward the white, blue and pink copies to the Department of Health and Environment

Form WWC-5