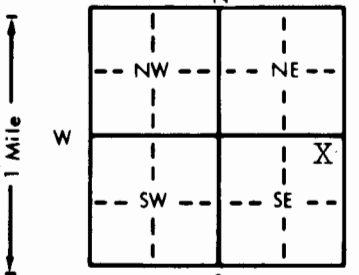


1 LOCATION OF WATER WELL:		Fraction		Section Number		Township Number		Range Number	
County: Meade		NE 1/4 NE 1/4 SE 1/4		25		T 33 S		R 30 E/W	
Distance and direction from nearest town or city street address of well if located within city?									
From Plains: 7 mi. South, 3 mi. East, 1 1/2 mi. South, 300' West									
2 WATER WELL OWNER:		Gary Evans							
RR#, St. Address, Box # :		P.O. Box 618							
City, State, ZIP Code :		Plains, Kansas 67869							
Board of Agriculture, Division of Water Resources									
Application Number: 35743									
3 LOCATE WELL'S LOCATION WITH AN "X" IN SECTION BOX:		4 DEPTH OF COMPLETED WELL: 316 ft. ELEVATION:							
		Depth(s) Groundwater Encountered 1. 176 ft. 2. ft. 3. ft.							
		WELL'S STATIC WATER LEVEL 176 ft. below land surface measured on mo/day/yr 4/7/82							
		Pump test data: Well water was 225 ft. after 1 hours pumping 1476 gpm							
		Est. Yield 2000 gpm: Well water was 235 ft. after 1 hours pumping 1731 gpm							
		Bore Hole Diameter 28 in. to 316 ft., and in. to ft.							
		WELL WATER TO BE USED AS:							
		5 Public water supply 8 Air conditioning 11 Injection well							
		1 Domestic 3 Feedlot 6 Oil field water supply 9 Dewatering 12 Other (Specify below)							
		2 Irrigation 4 Industrial 7 Lawn and garden only 10 Observation well							
		Was a chemical/bacteriological sample submitted to Department? Yes No X; If yes, mo/day/yr sample was submitted							
		Water Well Disinfected? Yes X No							
5 TYPE OF BLANK CASING USED:		CASING JOINTS: Glued Clamped							
1 Steel 3 RMP (SR) 5 Wrought iron 8 Concrete tile		Welded X							
2 PVC 4 ABS 6 Asbestos-Cement 9 Other (specify below)		Threaded							
Blank casing diameter 28 in. to 216 ft., Dia 36 in. to ft., Dia									
Casing height above land surface 12 in., weight 36.8 lbs./ft. Wall thickness or gauge No. 219									
TYPE OF SCREEN OR PERFORATION MATERIAL:		7 PVC 10 Asbestos-cement							
1 Steel 3 Stainless steel 5 Fiberglass 8 RMP (SR) 11 Other (specify)									
2 Brass 4 Galvanized steel 6 Concrete tile 9 ABS 12 None used (open hole)									
SCREEN OR PERFORATION OPENINGS ARE:		5 Gauzed wrapped 8 Saw cut 11 None (open hole)							
1 Continuous slot 3 Mill slot 6 Wire wrapped 9 Drilled holes									
2 Louvered shutter 4 Key punched 7 Torch cut 10 Other (specify) Bridge type									
SCREEN-PERFORATED INTERVALS: From 216 ft. to 316 ft., From ft. to ft.									
GRAVEL PACK INTERVALS: From 10 ft. to 316 ft., From ft. to ft.									
6 GROUT MATERIAL: 1 Neat cement 2 Cement grout 3 Bentonite 4 Other									
Grout Intervals: From 0 ft. to 10 ft., From ft. to ft., From ft. to ft.									
What is the nearest source of possible contamination:		10 Livestock pens 14 Abandoned water well							
1 Septic tank 4 Lateral lines 7 Pit privy 11 Fuel storage 15 Oil well/Gas well									
2 Sewer lines 5 Cess pool 8 Sewage lagoon 12 Fertilizer storage 16 Other (specify below)									
3 Watertight sewer lines 6 Seepage pit 9 Feedyard 13 Insecticide storage Unknown									
Direction from well?		How many feet?							
FROM	TO	LITHOLOGIC LOG	FROM	TO	LITHOLOGIC LOG				
0	10	Sandy clay							
10	53	Clay and caliche							
53	61	Sand with clay streaks							
61	110	Sand and gravel							
110	115	Sandrock							
115	140	Clean medium sand							
140	258	Clean medium sand							
258	312	Gray fine to medium sand							
312	340	Clay with little sand							
340	351	Blue clay, few sand streaks							
351	360	Shale							
7 CONTRACTOR'S OR LANDOWNER'S CERTIFICATION: This water well was (1) constructed, (2) reconstructed, or (3) plugged under my jurisdiction and was completed on (mo/day/year) 4/30/82 and this record is true to the best of my knowledge and belief. Kansas Water Well Contractor's License No. 102 This Water Well Record was completed on (mo/day/yr) 5/26/82 under the business name of Layne Western Co., Inc. by (signature) [Signature]									
INSTRUCTIONS: Use typewriter or ball point pen, PLEASE PRESS FIRMLY and PRINT clearly. Please fill in blanks, underline or circle the correct answers. Send top three copies to Kansas Department of Health and Environment, Division of Environment, Environmental Geology Section, Topeka, KS 66620. Send one to WATER WELL OWNER and retain one for your records.									