


1 LOCATION OF WATER WELL: Fraction NE 1/4 SE 1/4 SW 1/4 Section Number 4 Township Number T 33 S Range Number R 31 EW
 County: SEWARD

Distance and direction from nearest town or city street address of well if located within city?
FROM HAYNES, KS 1 BLOCK SOUTH OF ELEVATOR

2 WATER WELL OWNER: PAUL EATON
 RR#, St. Address, Box #: P.O. BOX 1397 Board of Agriculture, Division of Water Resources
 City, State, ZIP Code: LIBERAL, KS Application Number:

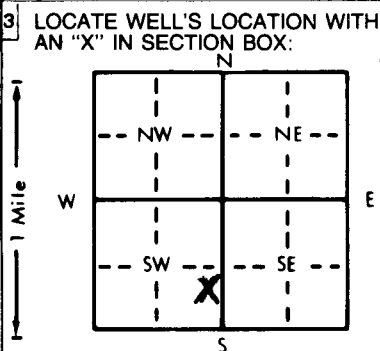

4 DEPTH OF COMPLETED WELL: 280 ft. ELEVATION:
 Depth(s) Groundwater Encountered 1. 180 ft. 2. _____ ft. 3. _____ ft.
 WELL'S STATIC WATER LEVEL 180 ft. below land surface measured on 08-17-95
 Pump test data: Well water was 195 ft. after 1 hours pumping 75 gpm
 Est. Yield 75 gpm: Well water was _____ ft. after _____ hours pumping _____ gpm
 Bore Hole Diameter 9 1/2 in. to 280 ft., and _____ in. to _____ ft.
 WELL WATER TO BE USED AS:
 1 Domestic 3 Feedlot 6 Oil field water supply 9 Dewatering 11 Injection well
 2 Irrigation 4 Industrial 7 Lawn and garden only 10 Monitoring well
 Was a chemical/bacteriological sample submitted to Department? Yes _____ No If yes, mo/day/yr sample was submitted _____
 Water Well Disinfected? Yes No _____

5 TYPE OF BLANK CASING USED:
 1 Steel 3 RMP (SR) 5 Wrought iron 8 Concrete tile CASING JOINTS: Glued Clamped _____
 2 PVC 4 ABS 6 Asbestos-Cement 9 Other (specify below) Welded _____
 7 Fiberglass Threaded _____
 Blank casing diameter 5 in. to 280 ft., Dia _____ in. to _____ ft., Dia _____ in. to _____ ft.
 Casing height above land surface 24 in., weight 2.902 lbs./ft. Wall thickness or gauge No. 280 SDR 21
 TYPE OF SCREEN OR PERFORATION MATERIAL:
 1 Steel 3 Stainless steel 5 Fiberglass 7 PVC 10 Asbestos-cement
 2 Brass 4 Galvanized steel 6 Concrete tile 8 RMP (SR) 11 Other (specify) _____
 9 ABS 12 None used (open hole)
 SCREEN OR PERFORATION OPENINGS ARE:
 1 Continuous slot 3 Mill slot 5 Gauzed wrapped 8 Saw cut 11 None (open hole)
 2 Louvered shutter 4 Key punched 6 Wire wrapped 9 Drilled holes
 7 Torch cut 10 Other (specify) _____
 SCREEN-PERFORATED INTERVALS: From 220 ft. to 280 ft., From _____ ft. to _____ ft.
 GRAVEL PACK INTERVALS: From 100 ft. to 280 ft., From _____ ft. to _____ ft.
 From _____ ft. to _____ ft., From _____ ft. to _____ ft.

6 GROUT MATERIAL: 1 Neat cement 2 Cement grout 3 Bentonite 4 Other **HOLE PLUG**
 Grout Intervals: From 0 ft. to 16 ft., From _____ ft. to _____ ft., From _____ ft. to _____ ft.
 What is the nearest source of possible contamination:
 1 Septic tank 4 Lateral lines 7 Pit privy 10 Livestock pens 14 Abandoned water well
 2 Sewer lines 5 Cess pool 8 Sewage lagoon 11 Fuel storage 15 Oil well/Gas well
 3 Watertight sewer lines 6 Seepage pit 9 Feedyard 12 Fertilizer storage 16 Other (specify below) _____
 13 Insecticide storage
 Direction from well? _____ How many feet? _____

| FROM | TO | LITHOLOGIC LOG | FROM | TO | PLUGGING INTERVALS |
|------|-----|---------------------|------|----|--------------------|
| 0 | 21 | SANDY CLAY | | | |
| 21 | 26 | CLAY | | | |
| 26 | 74 | CLAY & SAND STREAKS | | | |
| 74 | 98 | SANDY CLAY | | | |
| 98 | 273 | SAND & GRAVEL | | | |
| 273 | 280 | BLUE CLAY | | | |

7 CONTRACTOR'S OR LANDOWNER'S CERTIFICATION: This water well was constructed, (2) reconstructed, or (3) plugged under my jurisdiction and was completed on (mo/day/year) 08-17-95 and this record is true to the best of my knowledge and belief. Kansas Water Well Contractor's License No. KWWCL-430 This Water Well Record was completed on (mo/day/yr) 08-17-95 under the business name of HOWARD DRILG. CO. BOX 806 BEAVER, OK 73932 by (signature) _____