


1 LOCATION OF WATER WELL: Fraction NW 1/4 NW 1/4 NW 1/4 Section Number 34 Township Number T 33 S Range Number R 31 E (W)
 County: SEWARD

Distance and direction from nearest town or city street address of well if located within city?
FROM LIBERAL: NORTHEAST ON HWY 54 TO OLD MEADE LAKE 2 1/2 EAST, 2 SOUTH & SOUTHEAST INTO LOC.

2 WATER WELL OWNER: WINN ENTERPRISES C/O Rock Ormiston
 RR#, St. Address, Box #: P.O. BOX 725 Board of Agriculture, Division of Water Resources
 City, State, ZIP Code: Plains, KS 67869 Application Number:

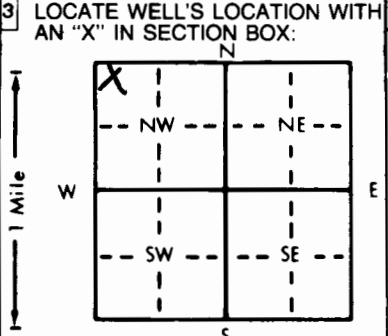

4 DEPTH OF COMPLETED WELL: 320 ft. ELEVATION:
 Depth(s) Groundwater Encountered 1. 200 ft. 2. ft. 3. ft.
 WELL'S STATIC WATER LEVEL 200 ft. below land surface measured on mo/day/yr 09-07-95
 Pump test data: Well water was 210 ft. after 1 hours pumping 100 gpm
 Est. Yield 100 gpm: Well water was ft. after hours pumping gpm
 Bore Hole Diameter: 11 in. to 320 ft., and in. to ft.
 WELL WATER TO BE USED AS:
 5 Public water supply 8 Air conditioning 11 Injection well
 1 Domestic 3 Feedlot 6 Oil field water supply 9 Dewatering 12 Other (Specify below)
2 Irrigation 4 Industrial 7 Lawn and garden only 10 Monitoring well
HOG FARM
 Was a chemical/bacteriological sample submitted to Department? Yes No X; If yes, mo/day/yr sample was submitted
 Water Well Disinfected? Yes X No

5 TYPE OF BLANK CASING USED:
 1 Steel 3 RMP (SR) 5 Wrought iron 8 Concrete tile CASING JOINTS: Glued X Clamped
2 PVC 4 ABS 6 Asbestos-Cement 9 Other (specify below) Welded
 7 Fiberglass Threaded
 Blank casing diameter 6 in. to 320 ft., Dia. in. to ft., Dia. in. to ft.
 Casing height above land surface 24 in., weight 2.902 lbs./ft. Wall thickness or gauge No. .280 SDR 21

TYPE OF SCREEN OR PERFORATION MATERIAL:
 1 Steel 3 Stainless steel 5 Fiberglass 8 RMP (SR) 10 Asbestos-cement 11 Other (specify)
 2 Brass 4 Galvanized steel 6 Concrete tile 9 ABS 12 None used (open hole)

SCREEN OR PERFORATION OPENINGS ARE:
 1 Continuous slot 3 Mill slot 5 Gauzed wrapped 8 Saw cut 11 None (open hole)
 2 Louvered shutter 4 Key punched 6 Wire wrapped 9 Drilled holes
 7 Torch cut 10 Other (specify)

SCREEN-PERFORATED INTERVALS: From 260 ft. to 320 ft., From ft. to ft.
 From ft. to ft., From ft. to ft.
 GRAVEL PACK INTERVALS: From 200 ft. to 320 ft., From ft. to ft.
 From ft. to ft., From ft. to ft.

6 GROUT MATERIAL: 1 Neat cement 2 Cement grout 3 Bentonite 4 Other HOLE PLUG
 Grout Intervals: From 0 ft. to 16 ft., From ft. to ft., From ft. to ft.

What is the nearest source of possible contamination:
 1 Septic tank 4 Lateral lines 7 Pit privy 10 Livestock pens 14 Abandoned water well
 2 Sewer lines 5 Cess pool 8 Sewage lagoon 11 Fuel storage 15 Oil well/Gas well
 3 Watertight sewer lines 6 Seepage pit 9 Feedyard 12 Fertilizer storage 16 Other (specify below)
 13 Insecticide storage
 Direction from well? How many feet?

| FROM | TO | LITHOLOGIC LOG | FROM | TO | PLUGGING INTERVALS |
|------|-----|---------------------|------|----|--------------------|
| 0 | 2 | CLAY | | | |
| 2 | 4 | CALICHE | | | |
| 4 | 12 | SANDY CLAY | | | |
| 12 | 55 | CALICHE CLAY | | | |
| 55 | 74 | SANDY CLAY | | | |
| 74 | 79 | SAND | | | |
| 79 | 90 | SANDY CLAY | | | |
| 90 | 106 | COARSE SAND | | | |
| 106 | 111 | SAND & CLAY STREAKS | | | |
| 111 | 194 | SAND | | | |
| 194 | 198 | SANDY CLAY | | | |
| 198 | 209 | SAND & CLAY STREAKS | | | |
| 209 | 314 | SAND & GRAVEL | | | |
| 314 | 320 | BLUE & GREEN CLAY | | | |

7 CONTRACTOR'S OR LANDOWNER'S CERTIFICATION: This water well was (1) constructed, (2) reconstructed, or (3) plugged under my jurisdiction and was completed on (mo/day/year) 09-07-95 and this record is true to the best of my knowledge and belief. Kansas Water Well Contractor's License No. KWCL-430 This Water Well Record was completed on (mo/day/yr) 09-07-95 under the business name of HOWARD, DRLG. CO. BOX 806 BEAVER, OK 73932 by (signature) [Signature]