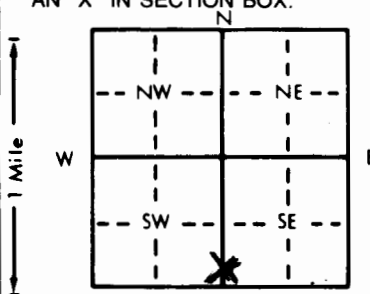


1 LOCATION OF WATER WELL: County: **SEWARD** Fraction: **C/S 1/2 S 1/2 1/2 S 1/2 1/2** Section Number: **14** Township Number: **T 33 S** Range Number: **R 31 EW**

Distance and direction from nearest town or city street address of well if located within city?  
**FROM BEAVER NORTH TO MEADE LAKE, TURN TO CURVE THEN WEST TO BLINKING LIGHT ON 4 MILES WEST & NORTH.**

2 WATER WELL OWNER: **DEKALB**  
 RR#, St. Address, Box # : **P.O. BOX 429** Board of Agriculture, Division of Water Resources  
 City, State, ZIP Code : **PLAINS, KS 67869** Application Number:

3 LOCATE WELL'S LOCATION WITH AN "X" IN SECTION BOX:  DEPTH OF COMPLETED WELL: **500** ft. ELEVATION: \_\_\_\_\_ ft.  
 Depth(s) Groundwater Encountered 1. **216** ft. 2. \_\_\_\_\_ ft. 3. \_\_\_\_\_ ft.  
 WELL'S STATIC WATER LEVEL **216** ft. below land surface measured on mo/day/yr **12-15-95**  
 Pump test data: Well water was **235** ft. after **1** hours pumping **110** gpm  
 Est. Yield **110** gpm: Well water was \_\_\_\_\_ ft. after \_\_\_\_\_ hours pumping \_\_\_\_\_ gpm  
 Bore Hole Diameter **11** in. to **500** ft., and \_\_\_\_\_ in. to \_\_\_\_\_ ft.  
 WELL WATER TO BE USED AS: 5 Public water supply 8 Air conditioning 11 Injection well  
 1 Domestic 3 Feedlot 6 Oil field water supply 9 Dewatering **12 Other (Specify below)**  
 2 Irrigation 4 Industrial 7 Lawn and garden only 10 Monitoring well **Hog farm**  
 Was a chemical/bacteriological sample submitted to Department? Yes \_\_\_\_\_ No **X**; If yes, mo/day/yr sample was submitted \_\_\_\_\_  
 Water Well Disinfected **XX** Yes **X** No

5 TYPE OF BLANK CASING USED: 5 Wrought iron 8 Concrete tile CASING JOINTS: Glued **X** Clamped \_\_\_\_\_  
 1 Steel 3 RMP (SR) 6 Asbestos-Cement 9 Other (specify below) Welded \_\_\_\_\_  
**2** PVC 4 ABS 7 Fiberglass \_\_\_\_\_ Threaded \_\_\_\_\_  
 Blank casing diameter **6** in. to **500** ft., Dia \_\_\_\_\_ in. to \_\_\_\_\_ ft., Dia \_\_\_\_\_ in. to \_\_\_\_\_ ft.  
 Casing height above land surface **24** in., weight **2.902** lbs./ft. Wall thickness or gauge No. **.280 SDR 21**  
 TYPE OF SCREEN OR PERFORATION MATERIAL: **7** PVC 10 Asbestos-cement  
 1 Steel 3 Stainless steel 5 Fiberglass 8 RMP (SR) 11 Other (specify) \_\_\_\_\_  
 2 Brass 4 Galvanized steel 6 Concrete tile 9 ABS 12 None used (open hole)  
 SCREEN OR PERFORATION OPENINGS ARE: 5 Gauzed wrapped **8** Saw cut 11 None (open hole)  
 1 Continuous slot 3 Mill slot 6 Wire wrapped 9 Drilled holes  
 2 Louvered shutter 4 Key punched 7 Torch cut 10 Other (specify) \_\_\_\_\_  
 SCREEN-PERFORATED INTERVALS: From **480** ft. to **500** ft., From \_\_\_\_\_ ft. to \_\_\_\_\_ ft.  
 GRAVEL PACK INTERVALS: From **380** ft. to **500** ft., From \_\_\_\_\_ ft. to \_\_\_\_\_ ft.

6 GROUT MATERIAL: **1** Neat cement 2 Cement grout 3 Bentonite **4** Other **HOLE PLUG**  
 Grout Intervals: From **0** ft. to **16** ft., From \_\_\_\_\_ ft. to \_\_\_\_\_ ft.  
 What is the nearest source of possible contamination:  
 1 Septic tank 4 Lateral lines 7 Pit privy 10 Livestock pens 14 Abandoned water well  
 2 Sewer lines 5 Cess pool 8 Sewage lagoon 11 Fuel storage 15 Oil well/Gas well  
 3 Watertight sewer lines 6 Seepage pit 9 Feedyard 12 Fertilizer storage 16 Other (specify below)  
 Direction from well? \_\_\_\_\_ How many feet? \_\_\_\_\_

FROM	TO	LITHOLOGIC LOG	FROM	TO	PLUGGING INTERVALS
0	2	TOP SOIL & CLAY	362	371	SANDY CLAY & BLUE CLAY
2	42	CLAY	371	380	SAND
42	60	CLAY & SANDY CLAY	380	390	FINE SAND
60	80	CLAY W/SAND STREAKS	390	400	COARSE SAND
80	100	SAND & SMALL GRAVEL	400	406	CLAY
100	123	COARSE SAND	406	440	COARSE SAND
123	140	CLAY	440	446	BLUE CLAY
140	162	SAND W/CLAY STREAKS	446	480	COARSE SAND
162	200	COARSE SAND	480	500	SAND & SANDY CLAY
200	222	SAND			
222	241	COARSE SAND W/CLAY STREAKS			
241	266	BLUE CLAY			
266	276	SANDY CLAY			
276	342	SAND			
342	362	BLUE CLAY			

7 CONTRACTOR'S OR LANDOWNER'S CERTIFICATION: This water well was **(1)** constructed, (2) reconstructed, or (3) plugged under my jurisdiction and was completed on (mo/day/year) **12-15-95** and this record is true to the best of my knowledge and belief. Kansas Water Well Contractor's License No. **KWNC430** This Water Well Record was completed on (mo/day/yr) **12-15-95** under the business name of **HOWARD DRUG CO. BOX 806 BEAVER, OK 73932** by (signature) *Howard Drug Co.*