


1 LOCATION OF WATER WELL: Fraction **C 1/4 SW 1/4 SW 1/4** Section Number **4** Township Number **T 33 S** Range Number **R 31W E (W)**

Distance and direction from nearest town or city street address of well if located within city?
1/8 MILES SOUTH WEST KISMET, KS

2 WATER WELL OWNER: **HARRIS OIL & GAS**
 RR#, St. Address, Box #: **1125 17TH ST STE 2290**
 City, State, ZIP Code: **DENVER, CO. 80202**

#1-4 BLOOM
 Board of Agriculture, Division of Water Resources
 Application Number: **960104**

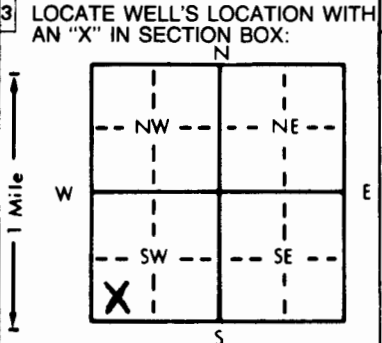

4 DEPTH OF COMPLETED WELL: **340** ft. ELEVATION: _____
 Depth(s) Groundwater Encountered 1. **220** ft. 2. _____ ft. 3. _____ ft.
 WELL'S STATIC WATER LEVEL: **220** ft. below land surface measured on mo/day/yr **03-19-96**
 Pump test data: Well water was **240** ft. after **1** hours pumping **100** gpm
 Est. Yield **100** gpm: Well water was _____ ft. after _____ hours pumping _____ gpm
 Bore Hole Diameter: **11** in. to **340** ft., and _____ in. to _____ ft.
 WELL WATER TO BE USED AS:
 1 Domestic 3 Feedlot **6** Oil field water supply 9 Dewatering 12 Other (Specify below)
 2 Irrigation 4 Industrial 7 Lawn and garden only 10 Monitoring well _____
 Was a chemical/bacteriological sample submitted to Department? Yes _____ No **X**; If yes, mo/day/yr sample was submitted _____
 Water Well Disinfected? Yes **X** No

5 TYPE OF BLANK CASING USED:
 1 Steel 3 RMP (SR) 5 Wrought iron 8 Concrete tile CASING JOINTS: Glued **X** Clamped _____
2 PVC 4 ABS 6 Asbestos-Cement 9 Other (specify below) Welded _____
 7 Fiberglass _____ Threaded _____
 Blank casing diameter: **6** in. to **340** ft., Dia. _____ in. to _____ ft., Dia. _____ in. to _____ ft.
 Casing height above land surface: **24** in., weight **2.902** lbs./ft. Wall thickness or gauge No. **.280 SDR 21**
 TYPE OF SCREEN OR PERFORATION MATERIAL:
 1 Steel 3 Stainless steel 5 Fiberglass **7** PVC 10 Asbestos-cement
 2 Brass 4 Galvanized steel 6 Concrete tile 8 RMP (SR) 11 Other (specify) _____
 9 ABS 12 None used (open hole)
 SCREEN OR PERFORATION OPENINGS ARE:
 1 Continuous slot 3 Mill slot 5 Gauzed wrapped **8** Saw cut 11 None (open hole)
 2 Louvered shutter 4 Key punched 6 Wire wrapped 9 Drilled holes
 7 Torch cut 10 Other (specify) _____
 SCREEN-PERFORATED INTERVALS: From **280** ft. to **340** ft., From _____ ft. to _____ ft.
 From _____ ft. to _____ ft., From _____ ft. to _____ ft.
 GRAVEL PACK INTERVALS: From **180** ft. to **340** ft., From _____ ft. to _____ ft.
 From _____ ft. to _____ ft., From _____ ft. to _____ ft.

6 GROUT MATERIAL: **1** Neat cement 2 Cement grout 3 Bentonite **4** Other **HOLE PLUG**
 Grout Intervals: From **0** ft. to **16** ft., From _____ ft. to _____ ft., From _____ ft. to _____ ft.
 What is the nearest source of possible contamination:
 1 Septic tank 4 Lateral lines 7 Pit privy 10 Livestock pens 14 Abandoned water well
 2 Sewer lines 5 Cess pool 8 Sewage lagoon 11 Fuel storage **15** Oil well/Gas well
 3 Watertight sewer lines 6 Seepage pit 9 Feedyard 12 Fertilizer storage 16 Other (specify below)
 13 Insecticide storage _____
 Direction from well? **Southeast** How many feet? **100**

FROM	TO	LITHOLOGIC LOG	FROM*	TO	PLUGGING INTERVALS
0	2	CLAY	334	340	CLAY
2	14	SAND			
14	20	CLAY			
20	48	CALICHE CLAY			
48	55	SANDY CLAY			
55	66	SMALL & MED. GRAVEL			
66	80	COARSE SAND			
80	106	COARSE SAND W/CLAY STREAKS			
106	150	COARSE SAND & SANDY CLAY			
150	197	COARSE SAND			
197	202	CLAY			
202	217	COARSE SAND W/CLAY STREAKS			
217	243	COARSE SAND			
243	257	COARSE SANDY CLAY			
257	334	COARSE SAND			

7 CONTRACTOR'S OR LANDOWNER'S CERTIFICATION: This water well was **(1)** constructed, (2) reconstructed, or (3) plugged under my jurisdiction and was completed on (mo/day/year) **03-19-96** and this record is true to the best of my knowledge and belief. Kansas Water Well Contractor's License No. **KWWCL-430** This Water Well Record was completed on (mo/day/yr) **03-19-96** under the business name of **HOWARD DRIG. CO. BOX 806 BEAVER, OK 73932** by (signature) _____

INSTRUCTIONS: Use typewriter or ball point pen. PLEASE PRESS FIRMLY and PRINT clearly. Please fill in blanks, underline or circle the correct answers. Send top three copies to Kansas Department of Health and Environment, Bureau of Water, Topeka, Kansas 66620-0001. Telephone: 913-296-5545. Send one to WATER WELL OWNER and retain one for your records.