


1 LOCATION OF WATER WELL: County: Seward	Fraction NE ¼ NW ¼ SW ¼	Section Number 4	Township Number 33	Range Number 31 E/W
---	-----------------------------------	----------------------------	------------------------------	-------------------------------

Distance and direction from nearest town or city street address of well if located within city?
At west edge of Kismet

2 WATER WELL OWNER: Water Well Owner: City of Kismet RR#, St. Address, Box #: PO Box 44 City, State, ZIP Code: Kismet Ks 67859	Global Positioning System (decimal degrees, min. of 4 digits) Latitude: _____ Longitude: _____ Elevation: _____ Datum: _____ Data Collection Method: _____
---	--

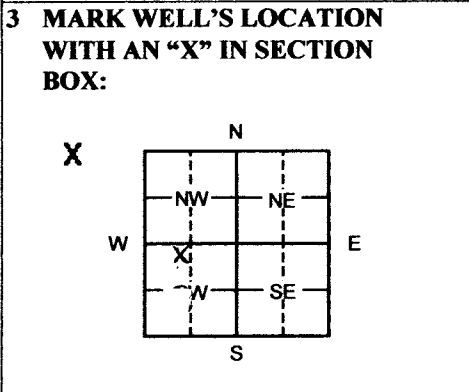

4 DEPTH OF WELL *Approx 350 ft.*

WELL'S STATIC WATER LEVEL **247** ft

WELL WAS USED AS:

<input type="checkbox"/> 1 Domestic	<input checked="" type="checkbox"/> 5 Public Water Supply	<input type="checkbox"/> 9 Dewatering
<input checked="" type="checkbox"/> 2 Irrigation	<input type="checkbox"/> 6 Oil Field Water Supply	<input type="checkbox"/> 10 Monitoring
<input type="checkbox"/> 3 Feedlot	<input type="checkbox"/> 7 Domestic (Lawn & Garden)	<input type="checkbox"/> 11 Injection Well
<input type="checkbox"/> 4 Industrial	<input type="checkbox"/> 8 Air Conditioning	<input type="checkbox"/> 12 Other _____

Was a chemical/bacteriological sample submitted to Department? Yes ___ No

5 TYPE OF BLANK CASING USED:

<input checked="" type="checkbox"/> 1 Steel	<input type="checkbox"/> 3 RMP (SR)	<input type="checkbox"/> 5 Wrought	<input type="checkbox"/> 7 Fiberglass	<input type="checkbox"/> 9 Other (Specify below) _____
<input type="checkbox"/> 2 PVC	<input type="checkbox"/> 4 ABS	<input type="checkbox"/> 6 Asbestos-Cement	<input type="checkbox"/> 8 Concrete Tile	

Blank casing diameter *10* in. Was casing pulled? Yes ___ No If yes, how much _____
Casing height above or below land surface *48* in.

6 GROUT PLUG MATERIAL: 1 Neat cement 2 Cement grout 3 Bentonite 4 Other _____

Grout Plug Intervals: From *4* ft. to *350* ft., From _____ ft. to _____ ft., From _____ to _____ ft.

What is the nearest source of possible contamination: None Observe

<input type="checkbox"/> 1 Septic tank	<input type="checkbox"/> 6 Seepage pit	<input type="checkbox"/> 11 Fuel Storage	<input type="checkbox"/> 16 Other (specify below) _____
<input type="checkbox"/> 2 Sewer lines	<input type="checkbox"/> 7 Pit privy	<input type="checkbox"/> 12 Fertilizer storage	
<input type="checkbox"/> 3 Watertight sewer lines	<input type="checkbox"/> 8 Sewage lagoon	<input type="checkbox"/> 13 Insecticide storage	
<input type="checkbox"/> 4 Lateral lines	<input type="checkbox"/> 9 Feedyard	<input type="checkbox"/> 14 Abandoned water well	Direction from well? _____
<input type="checkbox"/> 5 Cess pool	<input type="checkbox"/> 10 Livestock pens	<input type="checkbox"/> 15 Oil well/Gas well	How many feet? _____

FROM	TO	PLUGGING MATERIALS	FROM	TO	PLUGGING MATERIALS
<i>0</i>	<i>4</i>	Backfill			
<i>4</i>	<i>350</i>	Cement			

7 CONTRACTOR'S OR LANDOWNER'S CERTIFICATION: This water well was plugged under my jurisdiction and was completed on (mo/day/year) *2/27/08* and this record is true to the best of my knowledge and belief. Kansas Water Well Contractor's License No. *145*. This Water Well Record was completed on (mo/day/year) *7/18/08* under the business name of *Henkle Drilling & Supply* by (signature) *Bruce J. Reichmuth*

INSTRUCTIONS: Please fill in blanks or circle the correct answers. Send top three copies to Kansas Department of Health and Environment, Bureau of Water, Geology Section, 1000 SW Jackson St., Ste. 420, Topeka, Kansas 66612-1367. Telephone: 785/296-5522. Send one to Water Well Owner and retain one for your records. Visit us at <http://www.kdheks.gov/waterwell>.