USE TYPEWRITER OR BALL POINT PEN-PRESS FIRMLY, PRINT CLEARLY.

T R EW sec 1/4 1/4 1/4 No.

WATER WELL RECORD
KSA 82a-1201-1215

Kansas State Dept. Of Health
(Water Well Contractors)
Forbes-Bldg. 740
Topeka, Kansas 66620

Feed Lot Well #3 CWW Inv. #11227

1 Location of well:	County	Township name	Fraction	Section number	Town number	Range number
	Seward		NW SE SE	21	33S	31W

Distance and direction from nearest town or city: ½ Mi. East and 2¼ mi. South of Kismet
Street address of well location if in city:

3 Owner of well: Dekalb Feed Yard
Address: % Jason Starkweather
Plains, Kansas 67869

Locate with "X" in section below:

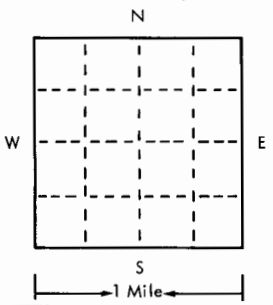

Sketch map:

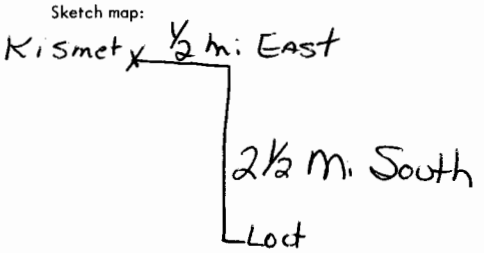

4 Well depth: 360 ft. Date of completion 4/17/75
Well diameter 15 in.

5 ☐ Cable tool ☒ Rotary ☐ Driven ☐ Dug
☐ Hollow rod ☐ Jetted ☐ Bored ☐ Reverse rotary

6 Use: ☐ Domestic ☐ Public supply ☒ Industry
☐ Irrigation ☐ Air conditioning ☐ Commercial
☐ Test well ☐ ~~XXXXXXXX~~

7 Casing: Material Steel Height: above/below
Threaded ☐ Welded ☐ Surface 18 in.
Diam. Weight 7.65 lbs./ft.
7 in. to 284 ft. depth Drive shoe? ☐ Yes ☒ No
7 in. to 360 ft. depth

2

Type and color of material	From	To
Surface	0	2
Clay Calcihe	2	37
Sandy Clay	37	77
Fine to Medium Sand	77	360
(use a second sheet if needed)		

8 Screen:
Manufacturer Doerr
Type Steel Dia. 7"
Slot/gauze 3/16" Length 60
Set between 284 ft. and 344 ft.
Fittings: 1/8 to 3/16
Gravel pack ☒ Yes ☐ No Size range of material

9 Static water level:
197 ft. below land surface Date 4/17/75

10 Pumping level below land surfaces:
ft. after hrs. pumping g.p.m.
ft. after hrs. pumping g.p.m.
Estimated maximum yield 160 g.p.m.

11 Water sample submitted:
☐ Yes ☒ No Date

12 Well head completion:
☐ Pitless adapter 18 Inches above grade

13 Well grouted? ☒ Yes ☐ No
☒ Neat cement ☐ Bentonite ☐
Depth: From 50 ft. to 25 ft.

14 Nearest source of possible contamination:
ft. 200 Direction NW Type Ans
Well disinfected upon completion? ☒ Yes ☐ No

15 Pump: ☒ Not installed
Manufacturer's name STA-RITE
Model number HP 15 Volts 208
Length of drop pipe 273 ft. capacity 160 g.m.p.
Type:
☒ Submersible ☐ Turbine
☐ Jet ☐ Reciprocating
☐ Certrifugal ☐ Other

16 Remarks: elevation

Topography:
☐ Hill
☐ Slope
☒ Upland
☐ Valley

17 Water well contractor's certification:
This well was drilled under my jurisdiction and this report is true to the best of my knowledge and belief.
Business name Carlile Water Well License No. 118
Address Box 275, Liberal, Ks.
Signed Edward E. Mesa Date
Authorized representative

Forward the white, blue and pink copies to the Kansas State Dept. Of Health.

Form WWC-5

677-H