


WATER WELL RECORD Form WWC-5 KSA 82a-1212

1 LOCATION OF WATER WELL: Fraction Section Number Township Number Range Number
 COUNTY: 088 SEWARD *1/4 NW 1/4* NW 1/4 1/4 25 T 33 S R 32 W

Distance and direction from nearest town or city street address of well if located within city?
 APPROX. 8 1/2 MILES EAST & 7 MILES NORTH OF LIBERAL

2 WATER WELL OWNER: PANHANDLE EASTERN PIPELIN
 RR#, St. Address, Box #: P.O. BOX 220, R.R. 1 Board of Agriculture, Division of Water Resources
 City, State, ZIP code: LIBERAL, KS 67901- Application Number: UNKNOWN

3 LOCATE WELL'S LOCATION WITH AN "X" IN SECTION BOX: 4 DEPTH OF COMPLETED WELL 17 ELEVATION: 0
 Depth(s) Groundwater Encountered 1. 0 ft. 2. 0 ft. 3. 0 ft.
 WELL'S STATIC WATER LEVEL 0 ft. below land surface measured on mo/day/yr 05/02/95
 Pump test data: Well water was 0 ft. after 0 hours pumping 0 gpm
 Estimated Yield 0 gpm; Well water was 0 ft. after 0 hours pumping 0 gpm
 Bore Hole Diameter in. to 0 ft., and in. to 0 ft.
 WELL WATER WAS: 04 INDUSTRIAL
 Was a chemical/bacteriological sample submitted to department? No ;
 If yes, mo/day/yr sample was submitted Water well disinfected? No

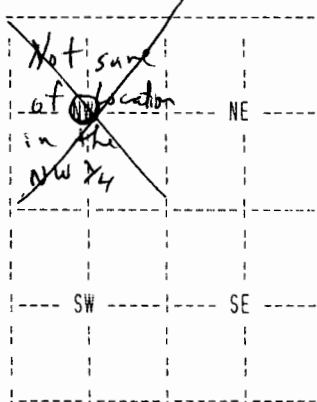

5 TYPE OF BLANK CASING USED: 01 STEEL CASING JOINTS: WELDED
 Blank casing diameter 12 in. to 17 ft., Dia in. to 0 ft., Dia in. to 0 ft.
 Casing height above land surface -48 in., weight 0 lbs/ft. Wall thickness or gauge No.
 TYPE OF SCREEN OR PERFORATION MATERIAL: 01 STEEL
 SCREEN OR PERFORATION OPENINGS ARE: UNKNOWN

SCREEN PERFORATED INTERVALS: From 0 ft. to 0 ft., From 0 ft. to 0 ft.
 GRAVEL PACK INTERVALS: From 0 ft. to 0 ft., From 0 ft. to 0 ft.
 From 0 ft. to 0 ft., From 0 ft. to 0 ft.

6 GROUT MATERIAL 02 CEMENT GROUT
 Grout Intervals: From 4 ft. to 17 ft., From 0 ft. to 0 ft., From 0 ft. to 0 ft.
 What is the nearest source of possible contamination: NONE OBSERVED
 Direction from well? How many feet? 0

FROM	TO	LITHOLOGIC LOG	FROM	TO	PLUGGING INTERVALS
			0	4	BACKFILL
			4	17	CEMENT GROUT
			0	0	
			0	0	
			0	0	
			0	0	
			0	0	
			0	0	
			0	0	

7 CONTRACTOR'S OR LANDOWNER'S CERTIFICATION: This water well was Plugged under my jurisdiction and was completed on (mo/day/year) 05/02/95 and this record is true to the best of my knowledge and belief. Kansas Water Well Contractor's License No. 145 This Water Well Record was completed on (mo/day/yr) 05/23/95 under the business name of HENKLE DRILLING & SUPPLY by (signature) Bruce J. Reichmuth