


1 LOCATION OF WATER WELL: Fraction **C** $\frac{1}{4}$ **NW** $\frac{1}{4}$ **NW** $\frac{1}{4}$ Section Number **3** Township Number **T 33 S** Range Number **R 32 EW**
 County: **Seward**

Distance and direction from nearest town or city street address of well if located within city?
Liberal; 7N., 4E., .3 to Loc.

2 WATER WELL OWNER: **Anadarko Petr.** #1 Jacquart "B"
 RR#, St. Address, Box #: **P.O. Box 351** Board of Agriculture, Division of Water Resources
 City, State, ZIP Code: **Liberal, Ks 67905** Application Number: **970362**

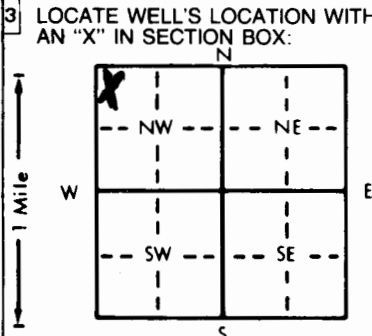

4 DEPTH OF COMPLETED WELL: **380** ft. ELEVATION:
 Depth(s) Groundwater Encountered 1. **219** ft. 2. ft. 3. ft.
 WELL'S STATIC WATER LEVEL: **219** ft. below land surface measured on mo/day/yr **9-12-97**
 Pump test data: Well water was **273** ft. after **1** hours pumping **95** gpm
 Est. Yield **95** gpm: Well water was ft. after hours pumping gpm
 Bore Hole Diameter: **11** in. to **380** ft., and in. to ft.
 WELL WATER TO BE USED AS:
 5 Public water supply 8 Air conditioning 11 Injection well
 1 Domestic 3 Feedlot **6** Oil field water supply 9 Dewatering 12 Other (Specify below)
 2 Irrigation 4 Industrial 7 Lawn and garden only 10 Monitoring well
 Was a chemical/bacteriological sample submitted to Department? Yes..... No **X**.....; If yes, mo/day/yr sample was submitted
 Water Well Disinfected? Yes **X** No

5 TYPE OF BLANK CASING USED:
 1 Steel 3 RMP (SR) 5 Wrought iron 8 Concrete tile CASING JOINTS: Glued **X** Clamped
2 PVC 4 ABS 6 Asbestos-Cement 9 Other (specify below) Welded
 7 Fiberglass Threaded
 Blank casing diameter **6** in. to **380** ft. Dia in. to ft. Dia in. to ft.
 Casing height above land surface **24** in. weight **2.902** lbs./ft. Wall thickness or gauge No. **.281** SDR **21**
 TYPE OF SCREEN OR PERFORATION MATERIAL:
 1 Steel 3 Stainless steel 5 Fiberglass **7** PVC 10 Asbestos-cement
 2 Brass 4 Galvanized steel 6 Concrete tile 8 RMP (SR) 11 Other (specify)
 12 None used (open hole)
 SCREEN OR PERFORATION OPENINGS ARE:
 1 Continuous slot 3 Mill slot 5 Gauzed wrapped **8** Saw cut 11 None (open hole)
 2 Louvered shutter 4 Key punched 6 Wire wrapped 9 Drilled holes
 7 Torch cut 10 Other (specify)
 SCREEN-PERFORATED INTERVALS: From **380** ft. to **320** ft., From ft. to ft.
 From ft. to ft., From ft. to ft.
 GRAVEL PACK INTERVALS: From **380** ft. to **220** ft., From ft. to ft.
 From ft. to ft., From ft. to ft.

6 GROUT MATERIAL: **1** Neat cement 2 Cement grout 3 Bentonite **4** Other **Hole Plug**
 Grout Intervals: From **0** ft. to **20** ft., From ft. to ft., From ft. to ft.
 What is the nearest source of possible contamination:
 1 Septic tank 4 Lateral lines 7 Pit privy 10 Livestock pens 14 Abandoned water well
 2 Sewer lines 5 Cess pool 8 Sewage lagoon 11 Fuel storage **15** Oil well/Gas well
 3 Watertight sewer lines 6 Seepage pit 9 Feedyard 12 Fertilizer storage 16 Other (specify below)
 13 Insecticide storage
 Direction from well? **North** How many feet? **600**

FROM	TO	LITHOLOGIC LOG	FROM	TO	PLUGGING INTERVALS
0	2	Sandy Clay			
2	25	clay			
25	48	Sandy Clay			
48	65	Sand			
65	91	Clay / Sandy Clay			
91	107	Caliche / Clay			
107	117	Coarse Sand			
117	125	Sandy Clay			
125	176	Sand			
176	187	Caliche / Clay			
187	260	Coarse Sand			
260	275	Sand w/clay streaks			
275	283	Coarse Sand			
283	288	Clay			
288	380	Coarse Sand			

7 CONTRACTOR'S OR LANDOWNER'S CERTIFICATION: This water well was **(1)** constructed, (2) reconstructed, or (3) plugged under my jurisdiction and was completed on (mo/day/year) **9-12-97** and this record is true to the best of my knowledge and belief. Kansas Water Well Contractor's License No. **KWCL - 430** This Water Well Record was completed on (mo/day/yr) **9-12-97** under the business name of **Howard Drlg. Box 806 Beaver, Ok 73932** by (signature) *[Signature]*

OFFICE USE ONLY
T
R
EW
SEC.
1/4
1/4
1/4