


1 LOCATION OF WATER WELL: Fraction $\frac{1}{4}$ $\frac{1}{4}$ SW $\frac{1}{4}$ Section Number 17 Township Number T 33 S Range Number R 32 **EW**
 County: SEWARD
 Distance and direction from nearest town or city street address of well if located within city?

2 WATER WELL OWNER: Shirley J. Beaty 1995 Revocable Trust dated 10/16/95
 RR#, St. Address, Box #: Shirley J. Beaty, Trustee Board of Agriculture, Division of Water Resources
 City, State, ZIP Code: P.O. Box 22570 Denver, CO 80222 Application Number:

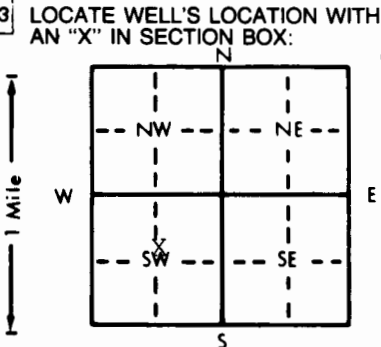

4 DEPTH OF COMPLETED WELL: 350 ft. ELEVATION:
 Depth(s) Groundwater Encountered 1. 42 ft. 2. ft. 3. ft.
 WELL'S STATIC WATER LEVEL ... 42 ft. below land surface measured on mo/day/yr 2-20-98
 Pump test data: Well water was . 67 ft. after . 1 1/2 hours pumping . 800 gpm
 Est. Yield 1200 gpm: Well water was 81 ft. after . 3 hours pumping . 1700 gpm
 Bore Hole Diameter . 28 in. to . 350 ft., and . in. to . ft.
 WELL WATER TO BE USED AS: 5 Public water supply 8 Air conditioning 11 Injection well
 1 Domestic 3 Feedlot 6 Oil field water supply 9 Dewatering 12 Other (Specify below)
 Irrigation 4 Industrial 7 Lawn and garden only 10 Observation well
 Was a chemical/bacteriological sample submitted to Department? Yes.....No.....; If yes, mo/day/yr sample was submitted
 Water Well Disinfected? Yes No

5 TYPE OF BLANK CASING USED: 5 Wrought iron 8 Concrete tile CASING JOINTS: Glued Clamped
 1 Steel 3 RMP (SR) 6 Asbestos-Cement 9 Other (specify below) Welded
 PVC 4 ABS 7 Fiberglass Threaded
 Blank casing diameter . . 16 in. to . 50 ft., Dia . . in. to . ft., Dia . . in. to . ft.
 Casing height above land surface . 12 in., weight . 19.75 lbs./ft. Wall thickness or gauge No. sd 26
 TYPE OF SCREEN OR PERFORATION MATERIAL: PVC 10 Asbestos-cement
 1 Steel 3 Stainless steel 5 Fiberglass 8 RMP (SR) 11 Other (specify)
 2 Brass 4 Galvanized steel 6 Concrete tile 9 ABS 12 None used (open hole)
 SCREEN OR PERFORATION OPENINGS ARE: 5 Gauzed wrapped 8 Saw cut 11 None (open hole)
 1 Continuous slot Mill slot 6 Wire wrapped 9 Drilled holes
 2 Louvered shutter 4 Key punched 7 Torch cut 10 Other (specify)
 SCREEN-PERFORATED INTERVALS: From . . . 50 ft. to . 350 ft., From . . . ft. to . . . ft.
 From . . . ft. to . . . ft., From . . . ft. to . . . ft.
 GRAVEL PACK INTERVALS: From . . . 20 ft. to . 350 ft., From . . . ft. to . . . ft.
 From . . . ft. to . . . ft., From . . . ft. to . . . ft.

6 GROUT MATERIAL: 1 Neat cement 2 Cement grout Bentonite 4 Other
 Grout Intervals: From . . . 0 ft. to . 20 ft., From . . . ft. to . . . ft., From . . . ft. to . . . ft.
 What is the nearest source of possible contamination:
 1 Septic tank 4 Lateral lines 7 Pit privy 10 Livestock pens 14 Abandoned water well
 2 Sewer lines 5 Cess pool 8 Sewage lagoon 11 Fuel storage 15 Oil well/Gas well
 3 Watertight sewer lines 6 Seepage pit 9 Feedyard 12 Fertilizer storage 16 Other (specify below)
 13 Insecticide storage None

Direction from well? How many feet?

FROM	TO	LITHOLOGIC LOG	FROM	TO	LITHOLOGIC LOG
0	15	top soil	340	350	fine sand
15	20	clay	350	360	red clay
20	90	med sand			
90	92	sandy clay			
92	165	coarse sand			
165	170	sandy clay			
170	185	fine sand			
185	190	clay			
190	195	med sand			
195	204	sandy clay			
204	240	sand with clay s&r			
240	265	fine sand			
265	300	clay			
300	330	med sand			
330	340	clay			

7 CONTRACTOR'S OR LANDOWNER'S CERTIFICATION: This water well was (1) constructed, reconstructed, or (3) plugged under my jurisdiction and was completed on (mo/day/year) . 2-18-98 and this record is true to the best of my knowledge and belief. Kansas Water Well Contractor's License No. 367 This Water Well Record was completed on (mo/day/yr) . 3-30-98 under the business name of Grosch Irrigation by (signature) *[Signature]*

INSTRUCTIONS: Use typewriter or ball point pen. PLEASE PRESS FIRMLY and PRINT clearly. Please fill in blanks, underline or circle the correct answers. Send top three copies to Kansas Department of Health and Environment, Bureau of Water Protection, Topeka, Kansas 66620-7320, Telephone: 913-862-9360. Send one to WATER WELL OWNER and retain one for your records.