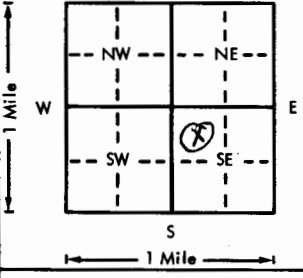


USE TYPEWRITER OR BALL POINT PEN-PRESS FIRMLY, PRINT CLEARLY.

WATER WELL RECORD
KSA 82a-1201-1215

Kansas Department of Health and Environment-Division of Environment
(Water well Contractors)
Topeka, Kansas 66620

Earl Rose #1 CWI Inv. # 12298

<input checked="" type="checkbox"/> Location of well:	County Seward	Fraction 1/4 NW 1/4 SE 1/4	Section number 13	Township number T 33 S R 32	Range number E/W
Distance and direction from nearest town or city: Liberal, 1 north, 3 West Street address of well location if in city:			2 1/4 miles east of Liberal, 1 north, 3 West		
3. Owner of well: R.R. or street: City, state, zip code:			CIG Exploration, Inc. Box 1322 Amarillo, Texas 79101		
4. Locate with "X" in section below: N 1 Mile W E S 1 Mile			Sketch map: 		
5. Type and color of material			From	To	6. Bore hole dia. 9" in. Completion date 5-15 Well depth 260 ft.
Surface			0	2	7. Cable tool <input checked="" type="checkbox"/> Rotary <input type="checkbox"/> Driven <input type="checkbox"/> Dug <input type="checkbox"/> Hollow rod <input type="checkbox"/> Jetted <input type="checkbox"/> Bored <input type="checkbox"/> Reverse rotary
Medium to large sand			2	120	8. Use: <input type="checkbox"/> Domestic <input type="checkbox"/> Public supply <input type="checkbox"/> Industry <input type="checkbox"/> Irrigation <input type="checkbox"/> Air conditioning <input type="checkbox"/> Stock <input type="checkbox"/> Lawn <input checked="" type="checkbox"/> Oil field water <input type="checkbox"/> Other
Clay and Medium to large sand 10-90			120	160	9. Casing: Material _____ Height: Above or below Threaded _____ Welded _____ Surface 28 in. RMP _____ PVC <input checked="" type="checkbox"/> Weight 2.78 lbs./ft. Dia. 5 in. to 175 ft. depth Wall Thickness: inches or Dia. 5 in. to 260 ft. depth gage No. .262
Fine sand and medium to large sand			160	256	10. Screen: Manufacturer's name _____ sawed perf. Type PVC Dia. 5" in. Slot/gauze .030 Length 80 Set between 175 ft. and 255 ft. Gravel pack? <input checked="" type="checkbox"/> yes Size range of material 1/8 to 3/16
Clay, Fine sand, Medium to large sand			256	260	11. Static water level: 135 ft. below land surface Date 5-15-76 mo./day/yr.
					12. Pumping level below land surfaces: _____ ft. after _____ hrs. pumping _____ g.p.m. _____ ft. after _____ hrs. pumping _____ g.p.m. Estimated maximum yield 60 g.p.m.
					13. Water sample submitted: _____ mo./day/yr. Yes <input checked="" type="checkbox"/> No <input type="checkbox"/> Date _____
					14. Well head completion: <input type="checkbox"/> Pitless adapter 28 inches above grade
					15. Well grouted? <input checked="" type="checkbox"/> yes With: <input checked="" type="checkbox"/> Neat cement <input type="checkbox"/> Bentonite <input type="checkbox"/> Concrete Depth: From 0 ft. to 10 ft.
					16. Nearest source of possible contamination: ft. 100 Direction NE Type oilwell Well disinfected upon completion? <input checked="" type="checkbox"/> Yes <input type="checkbox"/> No
					17. Pump: _____ Not installed Manufacturer's name _____ Model number _____ HP _____ Volts _____ Length of drop pipe _____ ft. capacity _____ g.p.m. Type: <input type="checkbox"/> Submersible <input type="checkbox"/> Turbine <input type="checkbox"/> Jet <input type="checkbox"/> Reciprocating <input type="checkbox"/> Centrifugal <input type="checkbox"/> Other
(Use a second sheet if needed)					
18. Elevation: Topography: <input type="checkbox"/> Hill <input type="checkbox"/> Slope <input checked="" type="checkbox"/> Upland <input type="checkbox"/> Valley	19. Remarks:		20. Water well contractor's certification: This well was drilled under my jurisdiction and this report is true to the best of my knowledge and belief. Carlile Water Well 118 Business name License No. Address Box 275, Liberal, Ks. Signed Edward E. Means Date 5-15-76 Authorized representative		

Forward the white, blue and pink copies to the Department of Health and Environment

Form WWC-5