


1 LOCATION OF WATER WELL: County: **Seward** Fraction: **SW 1/4 NE 1/4 SE 1/4** Section Number: **28** Township Number: **T 33 S** Range Number: **R 32 E** **(W)**

Distance and direction from nearest town or city street address of well if located within city?

1/2 miles E of Arkalon, KS

2 WATER WELL OWNER: **Elder & Vaughn** #1-28 Arkalon  
 RR#, St. Address, Box #: **P. O. Box 18938** Board of Agriculture, Division of Water Resources  
 City, State, ZIP Code: **Oklahoma City, OK 73154** Application Number: **910526**

3 LOCATE WELL'S LOCATION WITH AN "X" IN SECTION BOX:

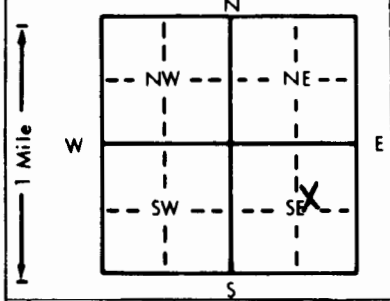

4 DEPTH OF COMPLETED WELL: **140** ft. ELEVATION: ..... ft.  
 Depth(s) Groundwater Encountered: 1. **100** ft. 2. .... ft. 3. .... ft.  
 WELL'S STATIC WATER LEVEL: **100** ft. below land surface measured on mo/day/yr: **11/15/91**  
 Pump test data: Well water was **103** ft. after **1** hours pumping **100** gpm  
 Est. Yield: **100** gpm. Well water was ..... ft. after ..... hours pumping ..... gpm  
 Bore Hole Diameter: **9 1/2** in. to **140** ft., and ..... in. to ..... ft.  
 WELL WATER TO BE USED AS:  
 1 Domestic 3 Feedlot **6 Oil field water supply** 8 Air conditioning 11 Injection well  
 2 Irrigation 4 Industrial 7 Lawn and garden only 10 Monitoring well 12 Other (Specify below)  
 Was a chemical/bacteriological sample submitted to Department? Yes..... No **X**..... If yes, mo/day/yr sample was submitted Water Well Disinfected? Yes **X** No

5 TYPE OF BLANK CASING USED:  
 1 Steel 3 RMP (SR) 5 Wrought iron 8 Concrete tile CASING JOINTS: Glued **X** Clamped .....  
**2 PVC** 4 ABS 6 Asbestos-Cement 9 Other (specify below) Welded .....  
 7 Fiberglass Threaded .....  
 Blank casing diameter: **5** in. to **140** ft., Dia. .... in. to ..... ft., Dia. .... in. to ..... ft.  
 Casing height above land surface: **24** in., weight ..... lbs./ft. Wall thickness or gauge No. **.032**  
 TYPE OF SCREEN OR PERFORATION MATERIAL:  
 1 Steel 3 Stainless steel 5 Fiberglass **7 PVC** 10 Asbestos-cement  
 2 Brass 4 Galvanized steel 6 Concrete tile 8 RMP (SR) 11 Other (specify) .....  
 12 None used (open hole)  
 SCREEN OR PERFORATION OPENINGS ARE:  
 1 Continuous slot 3 Mill slot 5 Gauzed wrapped **8 Saw cut** 11 None (open hole)  
 2 Louvered shutter 4 Key punched 6 Wire wrapped 9 Drilled holes  
 7 Torch cut 10 Other (specify) .....  
 SCREEN-PERFORATED INTERVALS: From **80** ft. to **140** ft., From ..... ft. to ..... ft.  
 GRAVEL PACK INTERVALS: From **40** ft. to **140** ft., From ..... ft. to ..... ft.

6 GROUT MATERIAL: **1 Neat cement** 2 Cement grout 3 Bentonite **4 Other Hole Plug**  
 Grout Intervals: From **1** ft. to **20** ft., From ..... ft. to ..... ft.  
 What is the nearest source of possible contamination:  
 1 Septic tank 4 Lateral lines 7 Pit privy 10 Livestock pens 14 Abandoned water well  
 2 Sewer lines 5 Cess pool 8 Sewage lagoon 11 Fuel storage **15 Oil well/Gas well**  
 3 Watertight sewer lines 6 Seepage pit 9 Feedyard 12 Fertilizer storage 16 Other (specify below)  
 13 Insecticide storage  
 Direction from well? **Southwest** How many feet? **150**

FROM	TO	LITHOLOGIC LOG	FROM	TO	PLUGGING INTERVALS
0	89	Sand			
89	90	Clay			
90	132	Sand			
132	140	Clay			

7 CONTRACTOR'S OR LANDOWNER'S CERTIFICATION: This water well was **(1)** constructed, (2) reconstructed, or (3) plugged under my jurisdiction and was completed on (mo/day/year) **11/15/91** and this record is true to the best of my knowledge and belief. Kansas Water Well Contractor's License No. **KWWCL-430**. This Water Well Record was completed on (mo/day/yr) **11/15/91** under the business name of **Howard Drilling Co. Box 806, Beaver, OK 73932** signature: *Howard Drilling Co.*

INSTRUCTIONS: Use typewriter or ball point pen. PLEASE PRESS FIRMLY and PRINT clearly. Please fill in blanks, underline or circle the correct answers. Send top three copies to Kansas Department of Health and Environment, Bureau of Water, Topeka, Kansas 66620-0001. Telephone: 913-296-5545. Send one to WATER WELL OWNER and retain one for your records.