


1	LOCATION OF WATER WELL:	Fraction	Section Number	Township Number	Range Number
County:	Seward	¼ NE ¼ NE ¼ SE	33	33S	33W EW

Distance and direction from nearest town or city street address of well if located within city?
 Liberal: N on 83 to Restlawn Cemetery--1 E to CR. J--1½ N on J and W into brick house--

2	WATER WELL OWNER:	Hatcher Land & Cattle Co.	Board of Agriculture, Division of Water Resources
RR #, St. Address, Box #:	7 East 11th St.	Application Number:	
City, State, ZIP Code :	Liberal, KS 67901		

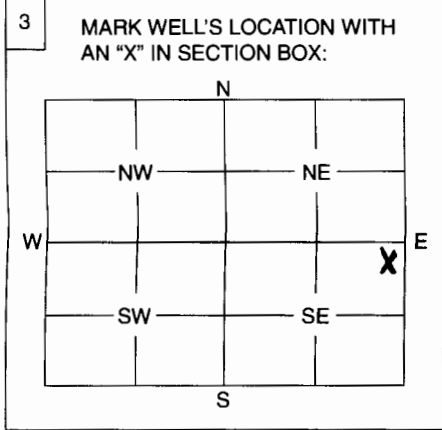

4 DEPTH OF WELL 360 ft.

WELL'S STATIC WATER LEVEL ft.

WELL WAS USED AS:

<input checked="" type="checkbox"/> 1 Domestic	5 Public Water Supply	9 Dewatering
<input type="checkbox"/> 2 Irrigation	6 Oil Field Water Supply	10 Monitoring Well
<input type="checkbox"/> 3 Feedlot	7 Domestic (Lawn & Garden)	11 Injection Well
<input type="checkbox"/> 4 Industrial	8 Air Conditioning	12 Other

Was a chemical / bacteriological sample submitted to Department? Yes No

If yes, mo/day/yr sample was submitted

Water Well Disinfected: Yes No

5 TYPE OF BLANK CASING USED:

1 Steel	3 RMP (SR)	5 Wrought	7 Fiberglass	9 Other (Specify below)
<input checked="" type="checkbox"/> 2 PVC	4 ABS	6 Asbestos-Cement	8 Concrete Tile	

Blank casing diameter 5 in. Was casing pulled? Yes No If yes, how much

Casing height above or below land surface 5 ft. in.

6 GROUT PLUG MATERIAL: 1 Neat cement 2 Cement grout 3 Bentonite 4 Other Hole plug

Grout Plug Intervals: From 30 ft. to 5 ft., From ft. to ft., From to ft.

What is the nearest source of possible contamination:

1 Septic tank	6 Seepage pit	11 Fuel storage	16 Other (specify below)
2 Sewer lines	7 Pit privy	12 Fertilizer storage	
3 Watertight sewer lines	8 Sewage lagoon	13 Insecticide storage	
4 Lateral lines	9 Feedyard	14 Abandoned water well	
5 Cess pool	10 Livestock pens	15 Oil well/Gas well	

Direction from well? How many feet?

FROM	TO	PLUGGING MATERIALS
360	240	Chlorinated Gravel
240	220	Hole Plug
220	60	Chlorinated Gravel
60	30	Hole Plug
30	5	Cement Grout
5	Surface	Topsoil

7 CONTRACTOR'S OF LANDOWNER'S CERTIFICATION: This water well was plugged under my jurisdiction and was completed on (mo/day/year) 08-24-11 and this record is true to the best of my knowledge and belief. Kansas Water Well Contractor's License No. 430 This Water Well Record was completed on (mo/day/year) 08-24-11 under the business name of Howard Drilling Co. Box 806 Beaver, OK 73932

by (signature) *[Signature]*

INSTRUCTIONS: Use typewriter or ball point pen. Please press firmly and print clearly. Please fill in blanks, underline or circle the correct answers. Send top three copies to Kansas Department of Health and Environment, Bureau of Water, Geology Section, 1000 SW Jackson St., Ste. 420, Topeka, Kansas 66612-1367. Telephone: 785/296-5522. Send one to Water Well Owner and retain one for your records.