


1 LOCATION OF WATER WELL: County: Seward	Fraction C 1/4 NE 1/4 NW 1/4	Section Number 6	Township Number T 33 S	Range Number R 33 EW
---	---------------------------------	---------------------	---------------------------	-------------------------

Distance and direction from nearest town or city street address of well if located within city? Liberal - 11 miles north 1 5/8 mi. west south into location.

2 WATER WELL OWNER: Mrs. Ben Jerman
 RR#, St. Address, Box # : Rt. 2
 City, State, ZIP Code : Liberal, Kansas 67901

Beredco, Inc./Slawson
 Board of Agriculture, Division of Water Resources
 Application Number: T89-51

3 LOCATE WELL'S LOCATION WITH AN "X" IN SECTION BOX:

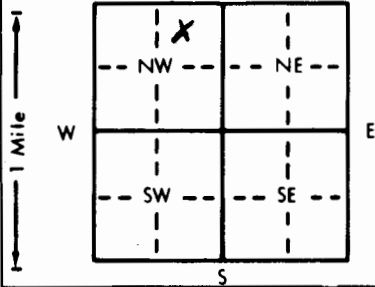

4 DEPTH OF COMPLETED WELL... 280 ft. ELEVATION:

Depth(s) Groundwater Encountered 1. ft. 2. ft. 3. ft.

WELL'S STATIC WATER LEVEL 180 ft. below land surface measured on mo/day/yr 2-8-89

Pump test data: Well water was ft. after hours pumping gpm

Est. Yield 100 gpm: Well water was ft. after hours pumping gpm

Bore Hole Diameter 9 7/8 in. to 280 ft., and in. to ft.

WELL WATER TO BE USED AS:

5 Public water supply	8 Air conditioning	11 Injection well
1 Domestic	3 Feedlot	6 Oil field water supply
2 Irrigation	4 Industrial	7 Lawn and garden only
		10 Monitoring well
		12 Other (Specify below)

Was a chemical/bacteriological sample submitted to Department? Yes.....No...X.....; If yes, mo/day/yr sample was submitted

Water Well Disinfected? Yes X No

5 TYPE OF BLANK CASING USED:

1 Steel	3 RMP (SR)	5 Wrought iron	8 Concrete tile	CASING JOINTS: Glued X Clamped
2 PVC	4 ABS	6 Asbestos-Cement	9 Other (specify below)	Welded
		7 Fiberglass		Threaded

Blank casing diameter 5.563 in. to 180 ft., Dia in. to ft., Dia in. to ft.

Casing height above land surface -4.8 in., weight 2.93 lbs./ft. Wall thickness or gauge No. 265

TYPE OF SCREEN OR PERFORATION MATERIAL:

1 Steel	3 Stainless steel	5 Fiberglass	8 RMP (SR)	11 Other (specify)
2 Brass	4 Galvanized steel	6 Concrete tile	9 ABS	12 None used (open hole)

SCREEN OR PERFORATION OPENINGS ARE:

1 Continuous slot	3 Mill slot	5 Gauzed wrapped	8 Saw cut	11 None (open hole)
2 Louvered shutter	4 Key punched	6 Wire wrapped	9 Drilled holes	
		7 Torch cut	10 Other (specify)	

SCREEN-PERFORATED INTERVALS: From 180 ft. to 280 ft., From ft. to ft.

GRAVEL PACK INTERVALS: From 22 ft. to 100 ft., From 120 ft. to 280 ft.

6 GROUT MATERIAL: 1 Neat cement 2 Cement grout 3 Bentonite 4 Other

Grout Intervals: From 4 ft. to 6 ft., From 6 ft. to 27 ft., From 130 ft. to 140 ft.

What is the nearest source of possible contamination:

1 Septic tank	4 Lateral lines	7 Pit privy	10 Livestock pens	14 Abandoned water well
2 Sewer lines	5 Cess pool	8 Sewage lagoon	11 Fuel storage	15 Oil well/Gas well
3 Watertight sewer lines	6 Seepage pit	9 Feedyard	12 Fertilizer storage	16 Other (specify below)
			13 Insecticide storage	

Direction from well? East How many feet? 150

FROM	TO	LITHOLOGIC LOG	FROM	TO	PLUGGING INTERVALS
0	4	Backfill .55 cu. ft. of backfill			
4	6	Neet cement .27 cu. ft. of neet cement			
6	27	Bentonite grout 2.86 cu. ft. of bentonite grout			
27	130	Chlorinated gravel 14.05 cu. ft. of chlorinated gravel			
130	140	Bentonite grout 1.36 cu. ft. of bentonite grout			
140	280	Chlorinated gravel 19.10 cu. ft. of chlorinated gravel			
5" PVC cap glued on top of casing @ 4' below ground level - cemented over then backfilled.					

7 CONTRACTOR'S OR LANDOWNER'S CERTIFICATION: This water well was (1) constructed, (2) reconstructed, or (3) plugged under my jurisdiction and was completed on (mo/day/year) 4-25-89 and this record is true to the best of my knowledge and belief. Kansas Water Well Contractor's License No. 118. This Water Well Record was completed on (mo/day/yr) 5-5-89 under the business name of Carlile Water Well Service, Inc. by (signature)