

County: Seward Fraction: Center Sec. 21 T. 33 S R. 34 W

CORRECTION(S) to WATER WELL COMPLETION RECORD Form WWC-5 (to rectify lacking or incorrect information)

Owner: Tuls Dairy Farms Irrigation well

If location corrected, was listed as:

Location changed to:

Section-Township-Range: _____

Fraction (1/4 calls): NW, NE, SW

Center

Other changes: Initial statements: _____

Changed to: _____

Comments: _____

Verification method: Confirmed well location with Google Earth, WIMAS, and KGS WW Database.

Initials: PKC Date: 7/6/2021

Submitted by: Kansas Geological Survey, Data Resources Library, 1930 Constant Ave., Lawrence, KS 66047-3724

Kansas Dept. of Health & Environment, Bureau of Water, 1000 SW Jackson, Suite 420, Topeka, KS 66612-1367

WATER WELL PLUGGING RECORD Form WWC-5P KSA 82a-1212 ID NO.


39963

1 LOCATION OF WATER WELL: Fraction 1/4 NW 1/4 NE 1/4 SW 1/4 Section Number 21 Township Number T 33 S Range Number 34 E W
 County: SEWARD

Street/Rural Address of Well Location: if unknown, distance & direction from nearest town or intersection: If at owner's address, check here From the intersection of C Road & 12 Rd.
1/2 mile East and 1/2 mile North

Global Positioning Systems (GPS) information:
 Latitude: 37.16281 (in decimal degrees)
 Longitude: -101.02227 (in decimal degrees)
 Elevation: _____
 Datum: WGS84, NAD83, NAD27
 Collection Method:
 GPS unit (Make/Model: Garmin eTrex 10)
 Digital Map/Photo. Topographic Map. Land Survey
 Est. Accuracy: < 3 m, 3-5 m, 5-15 m, > 15 m

2 WATER WELL OWNER: Tuls Dairy Farms
 RR#, St. Address, Box #: 8641 Road C
 City, State ZIP Code: Liberal Ks., 67901

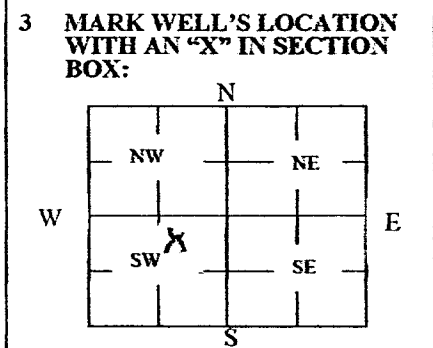

4 DEPTH OF WELL 404' ft.
 WELL'S STATIC WATER LEVEL 256' ft.
 WELL WAS USED AS:
 Domestic Public Water Supply Dewatering
 Irrigation Oil Field Water Supply Monitoring
 Feedlot Domestic (Lawn & Garden) Injection Well
 Industrial Air Conditioning Other _____
 Was a chemical/bacteriological sample submitted to Department? Yes No

5 TYPE OF BLANK CASING USED:
 Steel RMP (SR) Wrought Fiberglass Other (Specify below)
 PVC ABS Asbestos-Cement Concrete Tile
 Blank casing diameter 16" in. Was casing pulled? Yes No If yes, how much 60"
 Casing height above or below land surface Below 60" in.

6 GROUT PLUG MATERIAL: Neat cement Cement grout Bentonite Other _____
 Grout Plug Intervals: From 10' ft. to 5' ft., From _____ ft. to _____ ft., From _____ to _____ ft.
 What is the nearest source of possible contamination:
 Septic tank Seepage pit Fuel Storage Other (specify below)
 Sewer lines Pit privy Fertilizer storage
 Watertight sewer lines Sewage lagoon Insecticide storage
 Lateral lines Feedyard Abandoned water well Direction from well? West
 Cess pool Livestock pens Oil well/Gas well How many feet? Approx. 90'

FROM	TO	PLUGGING MATERIALS	FROM	TO	PLUGGING MATERIALS
404'	240'	Chlorinated Road Sand	240'	235'	Bentonite
235'	10'	Oversized Rock w/ Clay Chunks	10'	5'	3,000 PSI Concrete
5'	0'	Cut off casing and backfilled			

7 CONTRACTOR'S OR LANDOWNER'S CERTIFICATION: This water well was plugged under my jurisdiction and was completed on (mo/day/year) 6-11-2021 and this record is true to the best of my knowledge and belief. Kansas Water Well Contractor's License No. 145. This Water Well Record was completed on (mo/day/year) 6-14-2021 under the business name of Hydro Resources Mid Continent by (signature) Gary Clepper *Gary Clepper*

INSTRUCTIONS: Use typewriter or ballpoint pen. Please press firmly and print clearly. Please fill in blanks, underline or circle the correct answers. Send top three copies to Kansas Department of Health and Environment, Bureau of Water, Geology Section, 1000 SW Jackson St., Ste. 420, Topeka, Kansas 66612-1367. Telephone: 785/296-5524. Send one to Water Well Owner and retain one for your records. Visit us at <http://www.kdheks.gov/waterwell/index.html>.