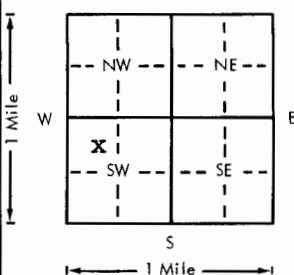
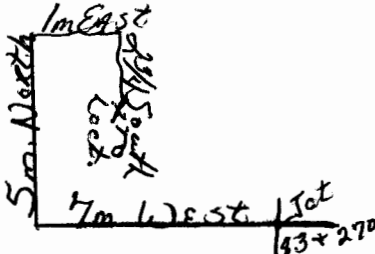


USE TYPEWRITER OR BALL POINT PEN-PRESS FIRMLY, PRINT CLEARLY.

CWW Inv. #14372

Hitch F-1

1. Location of well:	County Seward	Fraction 1/4 NW 1/4 SW 1/4	Section number 4	Township number T 33S	Range number S R 34W E/W
2. Distance and direction from nearest town or city: 9m Noth of Liberal go 7m We - 5m No. - 1m E Street address of well location if in city: 2 3/4m South to location.		3. Owner of well: Anadarko Production Company R.R. or street: c/o P. Gallin, Box 351 City, state, zip code: Liberal, Kansas 67901			
4. Locate with "X" in section below: N 		Sketch map: 		6. Bore hole dia. <u>9</u> in. Completion date <u>3-17</u> Well depth <u>320</u> ft.	
5. Type and color of material		From	To	7. <input checked="" type="checkbox"/> Cable tool <input checked="" type="checkbox"/> Rotary <input type="checkbox"/> Driven <input type="checkbox"/> Dug <input type="checkbox"/> Hollow rod <input type="checkbox"/> Jetted <input type="checkbox"/> Bored <input type="checkbox"/> Reverse rotary	
Surface		0	2	8. Use: <input type="checkbox"/> Domestic <input type="checkbox"/> Public supply <input checked="" type="checkbox"/> Industry <input type="checkbox"/> Irrigation <input type="checkbox"/> Air conditioning <input type="checkbox"/> Stock <input type="checkbox"/> Lawn <input checked="" type="checkbox"/> Oil field water <input type="checkbox"/> Other	
Fine sand		2	40	9. Casing: Material _____ Height: Above or below Threaded _____ Welded _____ Surface <u>28</u> in. RMP _____ PVC <input checked="" type="checkbox"/> Weight <u>2.78</u> lbs./ft. Dia. <u>5</u> in. to <u>210</u> ft. depth Wall Thickness: inches or Dia. <u>5</u> in. to <u>320</u> ft. depth gage No. <u>.265</u>	
Sandy clay		40	180	10. Screen: Manufacturer's name _____ Sawed perf. Type <u>PVC</u> Dia. <u>5"</u> Slot/gauze _____ Length <u>80'</u> Set between <u>210</u> ft. and <u>290</u> ft. _____ ft. and _____ ft. Gravel pack? <input checked="" type="checkbox"/> yes Size range of material <u>1/8-3/16</u>	
Medium to large sand & sandy clay 80-20		180	240	11. Static water level: _____ mo./day/yr. <u>140</u> ft. below land surface Date <u>3-17-78</u>	
Medium to large sand & blue sandy clay 70-30		240	260	12. Pumping level below land surfaces: _____ ft. after _____ hrs. pumping _____ g.p.m. _____ ft. after _____ hrs. pumping _____ g.p.m. Estimated maximum yield <u>60</u> g.p.m.	
Medium to large sand & blue sandy clay 80-20		260	295	13. Water sample submitted: _____ mo./day/yr. <input type="checkbox"/> Yes <input checked="" type="checkbox"/> No Date _____	
Blue clay		295	300	14. Well head completion: <input type="checkbox"/> Pitless adapter _____ <u>28</u> inches above grade	
clay		300	320	15. Well grouted? <input checked="" type="checkbox"/> yes With: <input checked="" type="checkbox"/> Neat cement <input type="checkbox"/> Bentonite <input type="checkbox"/> Concrete Depth: From <u>0</u> ft. to <u>10</u> ft.	
				16. Nearest source of possible contamination: ft. <u>100</u> Direction <u>NE</u> Type <u>oilwell</u> Well disinfected upon completion? <input checked="" type="checkbox"/> Yes <input type="checkbox"/> No	
				17. Pump: <input checked="" type="checkbox"/> Not installed Manufacturer's name _____ Model number _____ HP _____ Volts _____ Length of drop pipe _____ ft. capacity _____ g.p.m. Type: <input type="checkbox"/> Submersible <input type="checkbox"/> Turbine <input type="checkbox"/> Jet <input type="checkbox"/> Reciprocating <input type="checkbox"/> Centrifugal <input type="checkbox"/> Other	
				20. Water well contractor's certification: This well was drilled under my jurisdiction and this report is true to the best of my knowledge and belief. Carlile Water Well Ser. 118 Business name _____ License No. _____ Address <u>Box 275, Liberal, KS</u> Signed <u>Edward E. Means</u> Date <u>3-22-78</u> Authorized representative	
18. Elevation:		19. Remarks:			
Topography: <input type="checkbox"/> Hill <input type="checkbox"/> Slope <input checked="" type="checkbox"/> Upland <input type="checkbox"/> Valley					

T 33
 R 34W
 E
 Sec 4
 1/4 NW
 1/4 SW