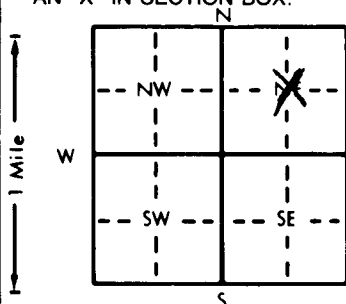


1 LOCATION OF WATER WELL: County: <b>STEVENS</b>	Fraction $\frac{1}{4}$ <b>C</b> $\frac{1}{4}$ <b>NE</b> $\frac{1}{4}$	Section Number <b>35</b>	Township Number <b>T 33 S</b>	Range Number <b>R 35W E</b> <b>(W)</b>
---	--	-----------------------------	----------------------------------	---

Distance and direction from nearest town or city street address of well if located within city?

**2 1/4 MILES SOUTHEAST WOODS, KS**2 WATER WELL OWNER: **TEXACO EXPL. & PROD.**RR#, St. Address, Box #: **BOX 2700**City, State, ZIP Code: **PAMPA, TX 79066-2700**# **35-2 SCHWEITZER G.F.**

Board of Agriculture, Division of Water Resources

Application Number: **950294**3 LOCATE WELL'S LOCATION WITH  
AN "X" IN SECTION BOX:4 DEPTH OF COMPLETED WELL: **380** ft. ELEVATION:Depth(s) Groundwater Encountered 1. **158** ft. 2. ft. 3. ft.WELL'S STATIC WATER LEVEL **158** ft. below land surface measured on mo/day/yr **09-14-95**Pump test data: Well water was **175** ft. after **1** hours pumping **100** gpmEst. Yield **100** gpm: Well water was ft. after hours pumping gpmBore Hole Diameter **11** in. to **380** ft., and in. to ft.

WELL WATER TO BE USED AS: 5 Public water supply 8 Air conditioning 11 Injection well

1 Domestic 3 Feedlot **6** Oil field water supply 9 Dewatering 12 Other (Specify below)

2 Irrigation 4 Industrial 7 Lawn and garden only 10 Monitoring well

Was a chemical/bacteriological sample submitted to Department? Yes No **X**; If yes, mo/day/yr sample was submittedWater Well Disinfected? Yes **X** No

5 TYPE OF BLANK CASING USED:

5 Wrought iron

8 Concrete tile

CASING JOINTS: Glued **X** Clamped

1 Steel

3 RMP (SR)

6 Asbestos-Cement

9 Other (specify below)

Welded

**2** PVC

4 ABS

7 Fiberglass

Threaded

Blank casing diameter **6** in. to **380** ft., Dia in. to ft.Casing height above land surface **24** in., weight **2,902** lbs./ft. Wall thickness or gauge No. **.280 SDR 21**

TYPE OF SCREEN OR PERFORATION MATERIAL:

1 Steel

3 Stainless steel

5 Fiberglass

**7** PVC

10 Asbestos-cement

2 Brass

4 Galvanized steel

6 Concrete tile

8 RMP (SR)

11 Other (specify)

12 None used (open hole)

SCREEN OR PERFORATION OPENINGS ARE:

1 Continuous slot

3 Mill slot

5 Gauzed wrapped

**8** Saw cut

11 None (open hole)

2 Louvered shutter

4 Key punched

6 Wire wrapped

9 Drilled holes

7 Torch cut

10 Other (specify)

SCREEN-PERFORATED INTERVALS: From **300** ft. to **380** ft., From ft. to ft.

From ft. to ft., From ft. to ft.

GRAVEL PACK INTERVALS: From **240** ft. to **380** ft., From ft. to ft.

From ft. to ft., From ft. to ft.

6 GROUT MATERIAL:

**1** Neat cement

2 Cement grout

3 Bentonite

**4** Other **HOLE PLUG**Grout Intervals: From **0** ft. to **16** ft., From ft. to ft., From ft. to ft.

What is the nearest source of possible contamination:

1 Septic tank

4 Lateral lines

7 Pit privy

10 Livestock pens

14 Abandoned water well

2 Sewer lines

5 Cess pool

8 Sewage lagoon

11 Fuel storage

**15** Oil well/Gas well

3 Watertight sewer lines

6 Seepage pit

9 Feedyard

12 Fertilizer storage

16 Other (specify below)

13 Insecticide storage

Direction from well?

*North*

How many feet?

*750*

FROM	TO	LITHOLOGIC LOG	FROM	TO	PLUGGING INTERVALS
0	12	SAND			
12	65	SANDY CLAY			
65	78	SAND			
78	92	SANDY CLAY & SAND			
92	158	SANDY CLAY & CLAY			
158	178	SAND & GRAVEL			
178	217	SAND & SANDY CLAY			
217	234	SAND & SANDY CLAY			
234	270	SAND			
270	296	SANDY CLAY			
296	349	SAND			
349	354	BROWN CLAY			
354	367	SAND			
367	380	BROWN CLAY			

7 CONTRACTOR'S OR LANDOWNER'S CERTIFICATION: This water well was **(1)** constructed, **(2)** reconstructed, or **(3)** plugged under my jurisdiction and was completed on (mo/day/year) **09-14-95** and this record is true to the best of my knowledge and belief. Kansas Water Well Contractor's License No. **KWCL-430** This Water Well Record was completed on (mo/day/yr) **09-14-95** under the business name of **HOWARD DRUG CO. BOX 806 BEAVER, OK 73932** by (signature) *Howard Drug Co.*