


1 LOCATION OF WATER WELL: County: STEVENS Fraction: NE 1/4 NE 1/4 SW 1/4 Section Number: 21 Township Number: T 33 S Range Number: R 35 ~~E/W~~

Distance and direction from nearest town or city street address of well if located within city?
 ONE AND ONE-HALF (1 1/2) MILES WEST AND ONE-HALF (1/2) MILE SOUTH OF WOODS, KANSAS.

2 WATER WELL OWNER: TERRY CAMPBELL
 RR#, St. Address, Box #: RT. 1, BOX 33A Board of Agriculture, Division of Water Resources
 City, State, ZIP Code: HUGOTON, KS 67951 Application Number: 41,747

3 LOCATE WELL'S LOCATION WITH AN "X" IN SECTION BOX: 4 DEPTH OF COMPLETED WELL: 695 ft. ELEVATION:

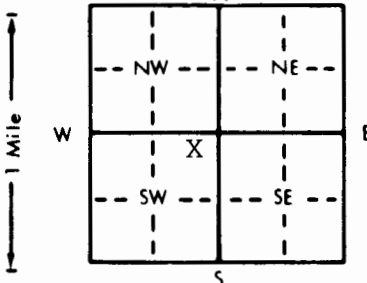

Depth(s) Groundwater Encountered 1. ft. 2. ft. 3. ft.
 WELL'S STATIC WATER LEVEL 220 ft. below land surface measured on mo/day/yr 4/16/96
 Pump test data: Well water was ft. after hours pumping gpm
 Est. Yield gpm: Well water was ft. after hours pumping gpm
 Bore Hole Diameter 26 in. to 695 ft., and in. to ft.
 WELL WATER TO BE USED AS: 5 Public water supply 8 Air conditioning 11 Injection well
 1 Domestic 3 Feedlot 6 Oil field water supply 9 Dewatering 12 Other (Specify below)
 2 Irrigation 4 Industrial 7 Lawn and garden only 10 Monitoring well
 Was a chemical/bacteriological sample submitted to Department? Yes No X; If yes, mo/day/yr sample was submitted Water Well Disinfected? Yes No

5 TYPE OF BLANK CASING USED: 5 Wrought iron 8 Concrete tile CASING JOINTS: Glued Clamped
 1 Steel 3 RMP (SR) 6 Asbestos-Cement 9 Other (specify below) Welded X
 2 PVC 4 ABS 7 Fiberglass Threaded

Blank casing diameter 16 in. to 695 ft. Dia in. to ft. Dia in. to ft.
 Casing height above land surface 12 in. weight 42.5 lbs./ft. Wall thickness or gauge No. 250

TYPE OF SCREEN OR PERFORATION MATERIAL: 7 PVC 10 Asbestos-cement
 1 Steel 3 Stainless steel 5 Fiberglass 8 RMP (SR) 11 Other (specify)
 2 Brass 4 Galvanized steel 6 Concrete tile 9 ABS 12 None used (open hole)

SCREEN OR PERFORATION OPENINGS ARE: 5 Gauzed wrapped 8 Saw cut 11 None (open hole)
 1 Continuous slot 2 Mill slot 6 Wire wrapped 9 Drilled holes
 2 Louvered shutter 4 Key punched 7 Torch cut 10 Other (specify)

SCREEN-PERFORATED INTERVALS: From PERF. 445 ft. to 575 ft. From SCREEN 575 ft. to 615 ft.
 From PERF. 615 ft. to 655 ft. From SCREEN 655 ft. to 695 ft.
 GRAVEL PACK INTERVALS: From 20 ft. to 695 ft. From ft. to ft.

6 GROUT MATERIAL: 1 Neat cement 2 Cement grout 3 Bentonite 4 Other
 Grout Intervals: From 0 ft. to 20 ft. From ft. to ft. From ft. to ft.

What is the nearest source of possible contamination:
 1 Septic tank 4 Lateral lines 7 Pit privy 10 Livestock pens 14 Abandoned water well
 2 Sewer lines 5 Cess pool 8 Sewage lagoon 11 Fuel storage 15 Oil well/Gas well
 3 Watertight sewer lines 6 Seepage pit 9 Feedyard 12 Fertilizer storage 13 Insecticide storage
 16 Other (specify below) CROPLAND-NOTHING IMMEDIATE VICINITY

Direction from well? How many feet?

FROM	TO	LITHOLOGIC LOG	FROM	TO	PLUGGING INTERVALS
0	240	SURFACE, CLAY & SAND			
240	360	FINE TO MED. SAND			
360	620	FINE TO MED. COARSE SAND			
620	660	FINE TO MED. SAND			
660	693	FINE TO MED. COARSE SAND			
693	720	RED CLAY			

7 CONTRACTOR'S OR LANDOWNER'S CERTIFICATION: This water well was 1 constructed, (2) reconstructed, or (3) plugged under my jurisdiction and was completed on (mo/day/year) 4/16/96 and this record is true to the best of my knowledge and belief. Kansas Water Well Contractor's License No. 225 This Water Well Record was completed on (mo/day/yr) 6/15/96 under the business name of KTM DRILLING, INC. by (signature) *Arnold Winters*