


1 LOCATION OF WATER WELL: County: Stevens Fraction: ~~SE~~ NE NE SE Section Number: 10 Township Number: T 33 S Range Number: R 35 E 10

Distance and direction from nearest town or city street address of well if located within city?
1/2 N of Woods

2 WATER WELL OWNER: Barry Harper
 RR#, St. Address, Box # : _____ Board of Agriculture, Division of Water Resources
 City, State, ZIP Code : Moscow, KS 67952 Application Number: _____

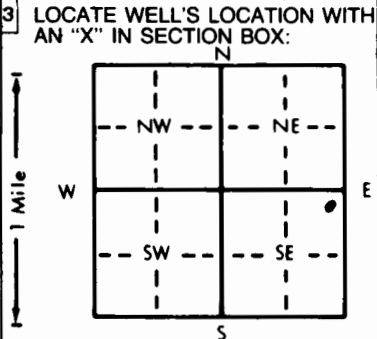

4 DEPTH OF COMPLETED WELL: 456 ft. ELEVATION: _____
 Depth(s) Groundwater Encountered 1. _____ ft. 2. _____ ft. 3. _____ ft.
 WELL'S STATIC WATER LEVEL: 141 ft. below land surface measured on mo/day/yr 4-6-98
 Pump test data: Well water was 145 ft. after 1 hours pumping 30 gpm
 Est. Yield _____ gpm: Well water was _____ ft. after _____ hours pumping _____ gpm
 Bore Hole Diameter: _____ in. to _____ ft., and _____ in. to _____ ft.
 WELL WATER TO BE USED AS:
 Domestic 3 Feedlot 6 Oil field water supply 9 Dewatering 12 Other (Specify below)
 Irrigation 4 Industrial 7 Lawn and garden only 10 Monitoring well
 Was a chemical/bacteriological sample submitted to Department? Yes _____ No ; If yes, mo/day/yr sample was submitted _____
 Water Well Disinfected? Yes No _____

5 TYPE OF BLANK CASING USED:
 1 Steel 3 RMP (SR) 5 Wrought iron 8 Concrete tile CASING JOINTS: Glued Clamped _____
 PVC 4 ABS 6 Asbestos-Cement 9 Other (specify below) Welded _____
 7 Fiberglass Threaded _____
 Blank casing diameter: 5 in. to 396 ft., Dia _____ in. to _____ ft., Dia _____ in. to _____ ft.
 Casing height above land surface: 18 in., weight _____ lbs./ft. Wall thickness or gauge No. 200 lb.
 TYPE OF SCREEN OR PERFORATION MATERIAL:
 PVC 10 Asbestos-cement
 1 Steel 3 Stainless steel 5 Fiberglass 8 RMP (SR) 11 Other (specify) _____
 2 Brass 4 Galvanized steel 6 Concrete tile 9 ABS 12 None used (open hole)
 SCREEN OR PERFORATION OPENINGS ARE:
 Saw cut 11 None (open hole)
 1 Continuous slot 3 Mill slot 6 Wire wrapped 9 Drilled holes
 2 Louvered shutter 4 Key punched 7 Torch cut 10 Other (specify) _____
 SCREEN-PERFORATED INTERVALS: From 396 ft. to 456 ft., From _____ ft. to _____ ft.
 GRAVEL PACK INTERVALS: From 20 ft. to 456 ft., From _____ ft. to _____ ft.

6 GROUT MATERIAL: 1 Neat cement 2 Cement grout Bentonite 4 Other _____
 Grout Intervals: From 4 ft. to 20 ft., From _____ ft. to _____ ft.
 What is the nearest source of possible contamination:
 Sewer lines 5 Cess pool 7 Pit privy 8 Sewage lagoon 9 Feedyard 10 Livestock pens 11 Fuel storage 12 Fertilizer storage 13 Insecticide storage 14 Abandoned water well 15 Oil well/Gas well 16 Other (specify below)
 3 Watertight sewer lines 6 Seepage pit
 Direction from well? SE How many feet? 120

FROM	TO	LITHOLOGIC LOG	FROM	TO	PLUGGING INTERVALS
0	11	sandy topsoil			
11	16	blue clay			
16	95	sand			
95	150	brown clay			
150	195	sand + gravel			
195	205	brown clay			
205	240	sand + gravel			
240	260	brown clay			
260	340	sand + gravel			
340	350	brown clay			
350	410	sand + gravel			
410	420	brown clay			
420	456	sand + gravel			

7 CONTRACTOR'S OR LANDOWNER'S CERTIFICATION: This water well was constructed, (2) reconstructed, or (3) plugged under my jurisdiction and was completed on (mo/day/year) 4-13-98 and this record is true to the best of my knowledge and belief. Kansas Water Well Contractor's License No. 101 This Water Well Record was completed on (mo/day/yr) 5-21-98 under the business name of Bartel Well Drilling, Inc. by (signature) Reuben J. Bartel

OFFICE USE ONLY
T
R
EW
SEC.