


WATER WELL RECORD Form WWC-5 KSA 82a-1212

1 LOCATION OF WATER WELL: County: STEVENS	Fraction SW 1/4 SE 1/4 NW 1/4	Section Number 7	Township Number T 33 S	Range Number R 35 E/W
--	----------------------------------	---------------------	---------------------------	-------------------------------------

Distance and direction from nearest town or city street address of well if located within city?
 NINE MILES EAST, ONE AND ONE-HALF NORTH, AND ONE-HALF EAST OF HUGOTON

2 WATER WELL OWNER: ROY WALKEMEYER / MARLIN HEGER
 RR#, St. Address, Box #: ROUTE 1, BOX 82
 City, State, ZIP Code: HUGOTON, KS 67951
 Board of Agriculture, Division of Water Resources
 Application Number: 040525-00

3 LOCATE WELL'S LOCATION WITH AN "X" IN SECTION BOX:
 4 DEPTH OF COMPLETED WELL: 670 ft. ELEVATION:
 Depth(s) Groundwater Encountered 1. ft. 2. ft. 3. ft.
 WELL'S STATIC WATER LEVEL: 168 ft. below land surface measured on mo/day/yr 6/9/93
 Pump test data: Well water was ft. after hours pumping gpm
 Est. Yield gpm: Well water was ft. after hours pumping gpm
 Bore Hole Diameter: 26 in. to 670 ft., and in. to ft.

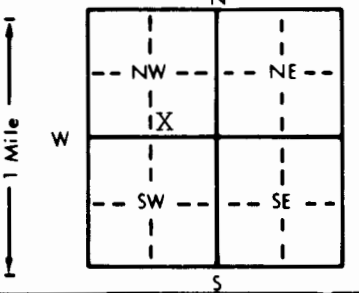

WELL WATER TO BE USED AS:
 1 Domestic 2 Irrigation 3 Feedlot 4 Industrial 5 Public water supply 6 Oil field water supply 7 Lawn and garden only 8 Air conditioning 9 Dewatering 10 Monitoring well 11 Injection well 12 Other (Specify below)
 Was a chemical/bacteriological sample submitted to Department? Yes. No. If yes, mo/day/yr sample was submitted
 Water Well Disinfected? Yes No

5 TYPE OF BLANK CASING USED:
 1 Steel 2 PVC 3 RMP (SR) 4 ABS 5 Wrought iron 6 Asbestos-Cement 7 Fiberglass 8 Concrete tile 9 Other (specify below)
 Blank casing diameter: 16 in. to 670 ft., Dia. in. to ft., Dia. in. to ft.
 Casing height above land surface: 12 in., weight: 42.5 lbs./ft. Wall thickness or gauge No. 250
 CASING JOINTS: Glued Clamped Welded Threaded

TYPE OF SCREEN OR PERFORATION MATERIAL:
 1 Steel 2 Brass 3 Stainless steel 4 Galvanized steel 5 Fiberglass 6 Concrete tile 7 PVC 8 RMP (SR) 9 ABS 10 Asbestos-cement 11 Other (specify) 12 None used (open hole)

SCREEN OR PERFORATION OPENINGS ARE:
 1 Continuous slot 2 Louvered shutter 3 Mill slot 4 Key punched 5 Gauzed wrapped 6 Wire wrapped 7 Torch cut 8 Saw cut 9 Drilled holes 10 Other (specify) 11 None (open hole)
 SCREEN-PERFORATED INTERVALS: From PERF. 310 ft. to 380 ft., From SCREEN 380 ft. to 400 ft.
 From PERF. 400 ft. to 608 ft., From SCREEN 608 ft. to 648 ft.
 GRAVEL PACK INTERVALS: From 20 ft. to 670 ft., From PERF. 648 ft. to 668 ft.
 From ft. to ft., From ft. to ft.

6 GROUT MATERIAL: 1 Neat cement 2 Cement grout 3 Bentonite 4 Other
 Grout Intervals: From 0 ft. to 20 ft., From ft. to ft., From ft. to ft.
 What is the nearest source of possible contamination:
 1 Septic tank 2 Sewer lines 3 Watertight sewer lines 4 Lateral lines 5 Cess pool 6 Seepage pit 7 Pit privy 8 Sewage lagoon 9 Feedyard 10 Livestock pens 11 Fuel storage 12 Fertilizer storage 13 Insecticide storage 14 Abandoned water well 15 Oil well/Gas well 16 Other (specify below) CROPLAND-NOTHING IMMEDIATE VICINITY

FROM	TO	LITHOLOGIC LOG	FROM	TO	PLUGGING INTERVALS
0	200	SURFACE			
200	260	FINE TO MED. SAND			
260	460	FINE, MED. & COARSE SAND			
460	540	FINE TO MED. SAND & GRAVEL			
540	665	FINE TO MED. SAND W/SOME COARSE			
665	675	RED BED			

7 CONTRACTOR'S OR LANDOWNER'S CERTIFICATION: This water well was (1) constructed, (2) reconstructed, or (3) plugged under my jurisdiction and was completed on (mo/day/year) 6/1/93 and this record is true to the best of my knowledge and belief. Kansas Water Well Contractor's License No. 225 This Water Well Record was completed on (mo/day/yr) 6/14/93 under the business name of KTM DRILLING, INC. by (signature) *Amold Winter*

INSTRUCTIONS: Use typewriter or ball point pen. PLEASE PRESS FIRMLY and PRINT clearly. Please fill in blanks, underline or circle the correct answers. Send top three copies to Kansas Department of Health and Environment, Bureau of Water, Topeka, Kansas 66620-0001. Telephone: 913-296-5545. Send one to WATER WELL OWNER and retain one for your records.

OFFICE USE ONLY T R E W SEC. 1/4 1/4 1/4